

Date: Wednesday, 2/20/2008 4:16:50 PM  
 User: Kim Johnston

## Process Sheet

11

Customer	: CU-DAR001 Dart Helicopters Services	Drawing Name	: HELI UTILITY BASKET LH/RH 350/355
Job Number	: 37512		
Estimate Number	: 10208		
P.O. Number	:	Part Number	: D350607043
This Issue	: 2/20/2008 S.O. No. :	Drawing Number	: D350-607 REV F P7-9
Prsht Rev.	: NC	Project Number	: N/A
First Issue	: / / Type : LARGE FAB ASSY	Drawing Revision	: F
Previous Run	: 37511	Material	:
Written By	:	Due Date	: 3/10/2008 Qty: 1 Um: Each
Checked & Approved By	: <u>08 02 21</u>		
Comment	: Est Rev:E as Per DSI9318 06-01-24 JLM		
	: Est Rev:F ECN1068 07-12-21 DD verified by:		

## Additional Product

Job Number:



Seq. #:	Machine Or Operation:	Description :
---------	-----------------------	---------------

1.0	DC	DOCUMENT CONTROL
-----	----	------------------



Comment: DOCUMENT CONTROL

Photocopy bluefile &amp; type labels per PPPD350-607-043 CHG004

08.02.21

2.0	37512A	BASKET LID ASSEMBLY
-----	--------	---------------------



Comment: Sub-Component BASKET LID ASSEMBLY

D2989-041 B 37512A

EB 08/05/23 @

3.0	37512B	BASKET LID ASSEMBLY
-----	--------	---------------------



Comment: Sub-Component BASKET LID ASSEMBLY

D2989-043 B 37512B

EB 08/05/23 @

4.0	37512C	BASKET BASE ASSEMBLY (350)
-----	--------	----------------------------



Comment: Sub-Component BASKET BASE ASSEMBLY (350)

D2221 B 37512C

EB 08/05/23 @

5.0	PACKAGING 1	PACKAGING RESOURCE #1
-----	-------------	-----------------------



Comment: PACKAGING-RESOURCE #1

Pick: Assembly Kit

6.0	NAS1515H4	Washer
-----	-----------	--------



Comment: Qty.: 2.0000 Each(s)/Unit Total: 2.0000 Each(s)

Pick: Assembly Kit

Qty Part Number Description Batch

2 NAS1515H4 WASHER

M 100919

JS 08/05/22 (X1)

W/O:		WORK ORDER CHANGES					
DATE	STEP	PROCEDURE CHANGE	By	Date	Qty	Approval Chief Eng / Prod Mgr	Approval QC Inspector

Part No: \_\_\_\_\_ PAR #: \_\_\_\_\_ Fault Category: \_\_\_\_\_ NCR: Yes No DQA: \_\_\_\_\_ Date: \_\_\_\_\_

QA: N/C Closed: \_\_\_\_\_ Date: \_\_\_\_\_

NCR:		WORK ORDER NON-CONFORMANCE (NCR)						
DATE	STEP	Description of NC Section A	Corrective Action Section B			Verification Section C	Approval Chief Eng	Approval QC Inspector
			Initial Chief Eng	Action Description Chief Eng	Sign & Date			

**NOTE:** Date & initial all entries

Date: , Wednesday, 2/20/2008 4:16:50 PM  
User: Kim Johnston

## Process Sheet

Customer: CU-DAR001 Dart Helicopters Services

Drawing Name: HELI UTILITY BASKET LH/RH 350/355

Job Number: 37512

Part Number: D350607043

Job Number:



Seq. #:

Machine Or Operation:

Description :

7.0

D2022101

Spacer



Comment: Qty.: 5.0000 Each(s)/Unit Total : 5.0000 Each(s)

Pick: Assembly Kit

Qty Part Number Description Batch

5 D2022-101 Spacer

33985

AS 08/05/22 (X)

8.0

D2258200

Weight Placard 200lb



Comment: Qty.: 1.0000 Each(s)/Unit Total : 1.0000 Each(s)

Pick: Assembly Kit

Qty Part Number Description Batch

1 D2258-200 Label

30848

AS 08/05/22 (X)

9.0

D2332041

Lid Prop Assembly 6.69"



Comment: Qty.: 1.0000 Each(s)/Unit Total : 1.0000 Each(s)

Pick: Assembly Kit

Qty Part Number Description Batch

1 D2332-041 Prop Ass'y

38597

AS 08/05/22 (X)

10.0

D2530

Handle Weldment



Comment: Qty.: 1.0000 Each(s)/Unit Total : 1.0000 Each(s)

Pick: Assembly Kit

Qty Part Number Description Batch

1 D2530 Handle Weldment

37853  
B37546

AS 08/05/22 (X)

11.0

D2535

Spring



Comment: Qty.: 2.0000 Each(s)/Unit Total : 2.0000 Each(s)

Pick: Assembly Kit

Qty Part Number Description Batch

2 D2535 Spring

37071

AS 08/05/22 (X)

12.0

D2537

Bushing



Comment: Qty.: 2.0000 Each(s)/Unit Total : 2.0000 Each(s)

Pick: Assembly Kit

Qty Part Number Description Batch

2 D2537 Bushing

37605

AS 08/05/22 (X)

W/O:		WORK ORDER CHANGES					
DATE	STEP	PROCEDURE CHANGE	By	Date	Qty	Approval Chief Eng / Prod Mgr	Approval QC Inspector

Part No: \_\_\_\_\_ PAR #: \_\_\_\_\_ Fault Category: \_\_\_\_\_ NCR: Yes No DQA: \_\_\_\_\_ Date: \_\_\_\_\_

QA: N/C Closed: \_\_\_\_\_ Date: \_\_\_\_\_

NCR:		WORK ORDER NON-CONFORMANCE (NCR)						
DATE	STEP	Description of NC Section A	Corrective Action Section B			Verification Section C	Approval Chief Eng	Approval QC Inspector
			Initial Chief Eng	Action Description Chief Eng	Sign & Date			

**NOTE:** Date & initial all entries

## Process Sheet

Customer: CU-DAR001 Dart Helicopters Services

Drawing Name: HELI UTILITY BASKET LH/RH 350/355

Job Number: 37512

Part Number: D350607043

Job Number:



Seq. #:

Machine Or Operation:

Description :

13.0

D27283

Dart Logo label large



Comment: Qty.: 2.0000 Each(s)/Unit Total : 2.0000 Each(s)

Pick: Assembly Kit

Qty Part Number

Description Batch

2 D2728-3

Label

22553

AS 08/05/22 (u)

14.0

D2931

Bumper



Comment: Qty.: 2.0000 Each(s)/Unit Total : 2.0000 Each(s)

Pick: Assembly Kit

Qty Part Number

Description Batch

2 D2931

Bumper

21139

AS 08/05/22 (u)

15.0

AN316A

Bolt



Comment: Qty.: 2.0000 Each(s)/Unit Total : 2.0000 Each(s)

Pick: Assembly Kit

Qty Part Number

Description Batch

2 AN3-16A

Bolt

M106815

AS 08/05/22 (u)

16.0

AN413A

Bolt



Comment: Qty.: 2.0000 Each(s)/Unit Total : 2.0000 Each(s)

Pick: Assembly Kit

Qty Part Number

Description Batch

2 AN4-13A

Bolt

M67534

AS 08/05/22 (u)

17.0

AN422A

Bolt



Comment: Qty.: 7.0000 Each(s)/Unit Total : 7.0000 Each(s)

Pick: Assembly Kit

Qty Part Number

Description Batch

7 AN4-22A

Bolt

M104937

AS 08/05/22 (u)

18.0

AN517A

Bolt



Comment: Qty.: 4.0000 Each(s)/Unit Total : 4.0000 Each(s)

Pick: Assembly Kit

Qty Part Number

Description Batch

4 AN5-17A

Bolt

M107939

AS 08/05/22 (u)

W/O:		WORK ORDER CHANGES					
DATE	STEP	PROCEDURE CHANGE	By	Date	Qty	Approval Chief Eng / Prod Mgr	Approval QC Inspector

Part No: \_\_\_\_\_ PAR #: \_\_\_\_\_ Fault Category: \_\_\_\_\_ NCR: Yes No DQA: \_\_\_\_\_ Date: \_\_\_\_\_

QA: N/C Closed: \_\_\_\_\_ Date: \_\_\_\_\_

NCR:		WORK ORDER NON-CONFORMANCE (NCR)						
DATE	STEP	Description of NC Section A	Corrective Action Section B			Verification Section C	Approval Chief Eng	Approval QC Inspector
			Initial Chief Eng	Action Description Chief Eng	Sign & Date			

**NOTE:** Date & initial all entries

Date: Wednesday, 2/20/2008 4:16:50 PM  
User: Kim Johnston

## Process Sheet

Customer: CU-DAR001 Dart Helicopters Services

Drawing Name: HELI UTILITY BASKET LH/RH 350/355

Job Number: 37512

Part Number: D350607043

Job Number:



Seq. #:

Machine Or Operation:

Description :

19.0

AN960JD8

Washer



Comment: Qty.: 2.0000 Each(s)/Unit Total : 2.0000 Each(s)

Pick: Assembly Kit

Qty Part Number Description Batch

2 AN960JD8 Washer

M107091

AS 08/05/22 (X)

20.0

AN960JD416

Washer



Comment: Qty.: 14.0000 Each(s)/Unit Total : 14.0000 Each(s)

Pick: Assembly Kit

Qty Part Number Description Batch

14 AN960JD416 Washer

M107321

AS 08/05/22 (X)

21.0

AN960JD416L

Washer



Comment: Qty.: 2.0000 Each(s)/Unit Total : 2.0000 Each(s)

Pick: Assembly Kit

Qty Part Number Description Batch

2 AN960JD416L Washer

M107008

AS 08/05/22 (X)

22.0

AN960JD516

Washer



Comment: Qty.: 4.0000 Each(s)/Unit Total : 4.0000 Each(s)

Pick: Assembly Kit

Qty Part Number Description Batch

4 AN960JD516 Washer

M107534

AS 08/05/22 (X)

23.0

AN9704

Washer



Comment: Qty.: 4.0000 Each(s)/Unit Total : 4.0000 Each(s)

Pick: Assembly Kit

Qty Part Number Description Batch

4 AN970-4 Washer

M107715

AS 08/05/22 (X)

24.0

MS20600AD4W3

Cherry Rivets



Comment: Qty.: 2.0000 Each(s)/Unit Total : 2.0000 Each(s)

Pick: Assembly Kit

Qty Part Number Description Batch

2 MS20600AD4W3 Rivet

M18071

AS 08/05/22 (X)

**Dart Aerospace Ltd**

W/O:		WORK ORDER CHANGES					
DATE	STEP	PROCEDURE CHANGE	By	Date	Qty	Approval Chief Eng / Prod Mgr	Approval QC Inspector

Part No: \_\_\_\_\_ PAR #: \_\_\_\_\_ Fault Category: \_\_\_\_\_ NCR: Yes No DQA: \_\_\_\_\_ Date: \_\_\_\_\_

QA: N/C Closed: \_\_\_\_\_ Date: \_\_\_\_\_

NCR:		WORK ORDER NON-CONFORMANCE (NCR)						
DATE	STEP	Description of NC Section A	Corrective Action Section B			Verification Section C	Approval Chief Eng	Approval QC Inspector
			Initial Chief Eng	Action Description Chief Eng	Sign & Date			

**NOTE:** Date & initial all entries



Date: Wednesday, 2/20/2008 4:16:50 PM  
User: Kim Johnston

## Process Sheet

Customer: CU-DAR001 Dart Helicopters Services

Drawing Name: HELI UTILITY BASKET LH/RH 350/355

Job Number: 37512

Part Number: D350607043

Job Number:



Seq. #:

Machine Or Operation:

Description :

25.0

MS21042L3

Nut



Comment: Qty.: 2.0000 Each(s)/Unit Total : 2.0000 Each(s)

Pick: Assembly Kit

Qty Part Number Description Batch

2 MS21042L3 Nut (or -3)

M107644

JS 08/05/22 (X)

26.0

MS21042L4

Nut



Comment: Qty.: 9.0000 Each(s)/Unit Total : 9.0000 Each(s)

Pick: Assembly Kit

Qty Part Number Description Batch

9 MS21042L4 Nut (or -4)

M166051

JS 08/05/22 (X)

27.0

MS21042L5

Nut



Comment: Qty.: 4.0000 Each(s)/Unit Total : 4.0000 Each(s)

Pick: Assembly Kit

Qty Part Number Description Batch

4 MS21042L5 Nut (or -5)

M167464

JS 08/05/22 (X)

28.0

SMALL FAB 1

SMALL & MEDIUM FAB RESOURCE 1



Comment: SMALL & MEDIUM FAB RESOURCE 1

Assemble as per Dwg D350-607

Seal Support Gusset with Sikaflex -291

Batch: M107804

Exp Date: 10/2008

CB 08/05/23 (X)

29.0

QC5

INSPECT WORK TO CURRENT STEP



08/05/23 (X)

Comment: INSPECT WORK TO CURRENT STEP

30.0

PACKAGING 1

PACKAGING RESOURCE #1



Comment: PACKAGING RESOURCE #1

Pick: Packing Kit

W/O:		WORK ORDER CHANGES					
DATE	STEP	PROCEDURE CHANGE	By	Date	Qty	Approval Chief Eng / Prod Mgr	Approval QC Inspector

Part No: \_\_\_\_\_ PAR #: \_\_\_\_\_ Fault Category: \_\_\_\_\_ NCR: Yes No DQA: \_\_\_\_\_ Date: \_\_\_\_\_

QA: N/C Closed: \_\_\_\_\_ Date: \_\_\_\_\_

NCR:		WORK ORDER NON-CONFORMANCE (NCR)						
DATE	STEP	Description of NC Section A	Corrective Action Section B			Verification Section C	Approval Chief Eng	Approval QC Inspector
			Initial Chief Eng	Action Description Chief Eng	Sign & Date			

**NOTE:** Date & initial all entries

Date: Wednesday, 2/20/2008 4:16:51 PM  
User: Kim Johnston

## Process Sheet

Customer: CU-DAR001 Dart Helicopters Services

Drawing Name: HELI UTILITY BASKET LH/RH 350/355

Job Number: 37512

Part Number: D350607043

Job Number:



Seq. #:

Machine Or Operation:

Description :

31.0

D22301

Mounting Lug



Comment: Qty.: 4.0000 Each(s)/Unit Total : 4.0000 Each(s)

Pick: Packing Kit

Qty Part Number

Description Batch

4 D2230-1

Lug

38740

JS 08/05/22 (X)

32.0

D22303

Mounting Lug



Comment: Qty.: 4.0000 Each(s)/Unit Total : 4.0000 Each(s)

Pick: Packing Kit

Qty Part Number

Description Batch

4 D2230-3

Clamp

37918

JS 08/05/22 (X)

33.0

D23241

Strut Assembly



Comment: Qty.: 1.0000 Each(s)/Unit Total : 1.0000 Each(s)

Pick: Packing Kit

Qty Part Number

Description Batch

1 \*D2324-1

Strut Ass'y

36749

JS 08/05/22 (X)

34.0

D2732

Rubber Extrusion



Comment: Qty.: 2.0000 f(s)/Unit Total : 2.0000 f(s)

Rubber Extrusion

8x D2732-030 (cut to 3")

Batch:

37632

JS 08/05/22 (X)

35.0

AN412A

Bolt



Comment: Qty.: 5.0000 Each(s)/Unit Total : 5.0000 Each(s)

Pick: Packing Kit

Qty Part Number

Description Batch

5 AN4-12A

Bolt

M105743

JS 08/05/22 (X)

36.0

AN413A

Bolt



Comment: Qty.: 2.0000 Each(s)/Unit Total : 2.0000 Each(s)

Pick: Packing Kit

Qty Part Number

Description Batch

2 AN4-13A

Bolt

M107534

JS 08/05/22 (X)

W/O:		WORK ORDER CHANGES					
DATE	STEP	PROCEDURE CHANGE	By	Date	Qty	Approval Chief Eng / Prod Mgr	Approval QC Inspector

Part No: \_\_\_\_\_ PAR #: \_\_\_\_\_ Fault Category: \_\_\_\_\_ NCR: Yes No DQA: \_\_\_\_\_ Date: \_\_\_\_\_

QA: N/C Closed: \_\_\_\_\_ Date: \_\_\_\_\_

NCR:		WORK ORDER NON-CONFORMANCE (NCR)						
DATE	STEP	Description of NC Section A	Corrective Action Section B			Verification Section C	Approval Chief Eng	Approval QC Inspector
			Initial Chief Eng	Action Description Chief Eng	Sign & Date			

NOTE: Date & initial all entries

Date: Wednesday, 2/20/2008 4:16:51 PM  
User: Kim Johnston

## Process Sheet

Customer: CU-DAR001 Dart Helicopters Services

Drawing Name: HELI UTILITY BASKET LH/RH 350/355

Job Number: 37512

Part Number: D350607043

Job Number:



Seq. #:

Machine Or Operation:

Description :

37.0

AN415A

Bolt



Comment: Qty.: 8.0000 Each(s)/Unit Total : 8.0000 Each(s)

Bolt

Batch: M107321

AS 08/05/22 (X)

38.0

AN960JD416

Washer



Comment: Qty.: 26.0000 Each(s)/Unit Total : 26.0000 Each(s)

Pick: Packing Kit

Qty Part Number Description Batch

26 AN960JD416 Washer M107321

AS 08/05/22 (X)

39.0

MS21042L4

Nut



Comment: Qty.: 13.0000 Each(s)/Unit Total : 13.0000 Each(s)

Pick: Packing Kit

Qty Part Number Description Batch

13 MS21042L4 Nut (or -4) M106051

AS 08/03/22 (X)

40.0

QC4

INSPECT 100% KITS FOR COMPLETENESS



Comment: INSPECT 100% KITS FOR COMPLETENESS

0805-23 (D)

41.0

PACKAGING 1

PACKAGING RESOURCE #1



Comment: PACKAGING RESOURCE #1

Identify and pack for shipping as per PPP D350-607-043

Location: F

8/5/23 5d (X)

42.0

QC21

FINAL INSPECTION/W/O RELEASE



Comment: FINAL INSPECTION/W/O RELEASE

08/05/23 (X)

Job Completion



mf 08-05-23

**Dart Aerospace Ltd**


W/O:		WORK ORDER CHANGES					
DATE	STEP	PROCEDURE CHANGE	By	Date	Qty	Approval Chief Eng / Prod Mgr	Approval QC Inspector

Part No: \_\_\_\_\_ PAR #: \_\_\_\_\_ Fault Category: \_\_\_\_\_ NCR: Yes No DQA: \_\_\_\_\_ Date: \_\_\_\_\_

QA: N/C Closed: \_\_\_\_\_ Date: \_\_\_\_\_

NCR:		WORK ORDER NON-CONFORMANCE (NCR)						
DATE	STEP	Description of NC Section A	Corrective Action Section B			Verification Section C	Approval Chief Eng	Approval QC Inspector
			Initial Chief Eng	Action Description Chief Eng	Sign & Date			

**NOTE:** Date & initial all entries

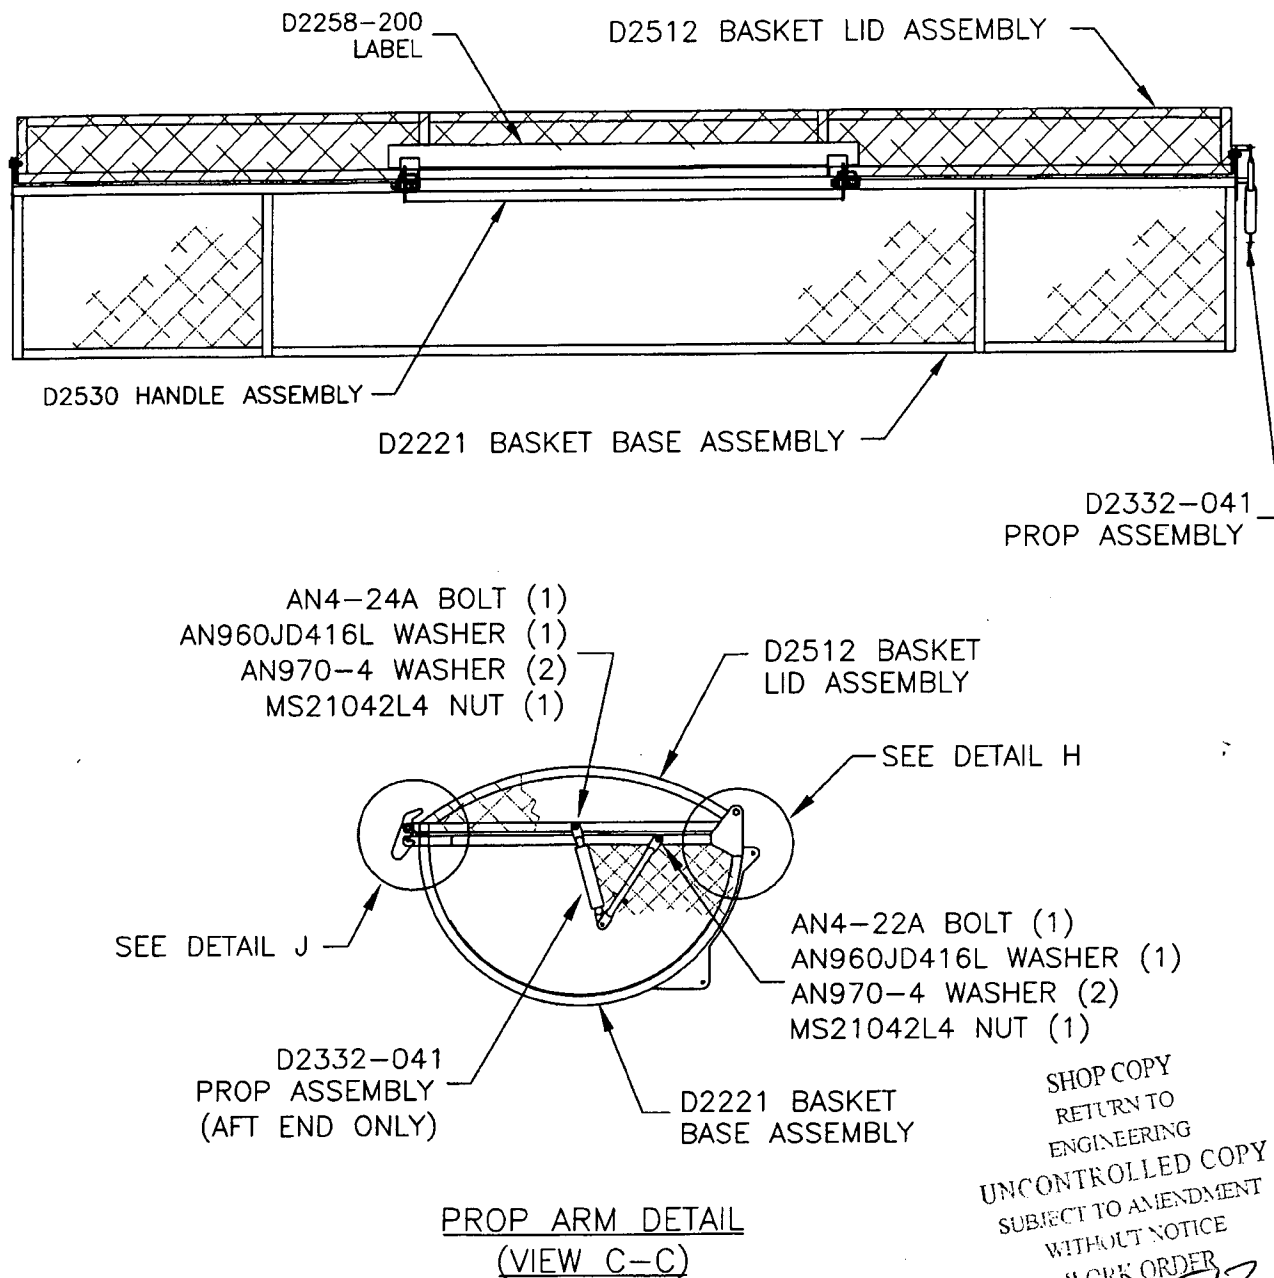


**Figure 4 – Basket Replacement Parts**  
(D350-607-041 Heli-Utility-Basket™)

• COPYRIGHT © 1994 BY DART AEROSPACE LTD. •  
THIS DOCUMENT IS PRIVATE AND CONFIDENTIAL AND IS SUPPLIED ON THE EXPRESS CONDITION THAT IT IS NOT TO BE USED FOR ANY PURPOSE OR COPIED OR COMMUNICATED TO ANY OTHER PERSON WITHOUT WRITTEN PERMISSION FROM DART AEROSPACE LTD.

Revision: **F**  
Date: 03.01.17

SHOP COPY  
RETURN TO  
ENGINEERING  
UNCONTROLLED COPY  
SUBJECT TO AMENDMENT  
WITHOUT NOTICE  
WORK ORDER  
NO. 37512

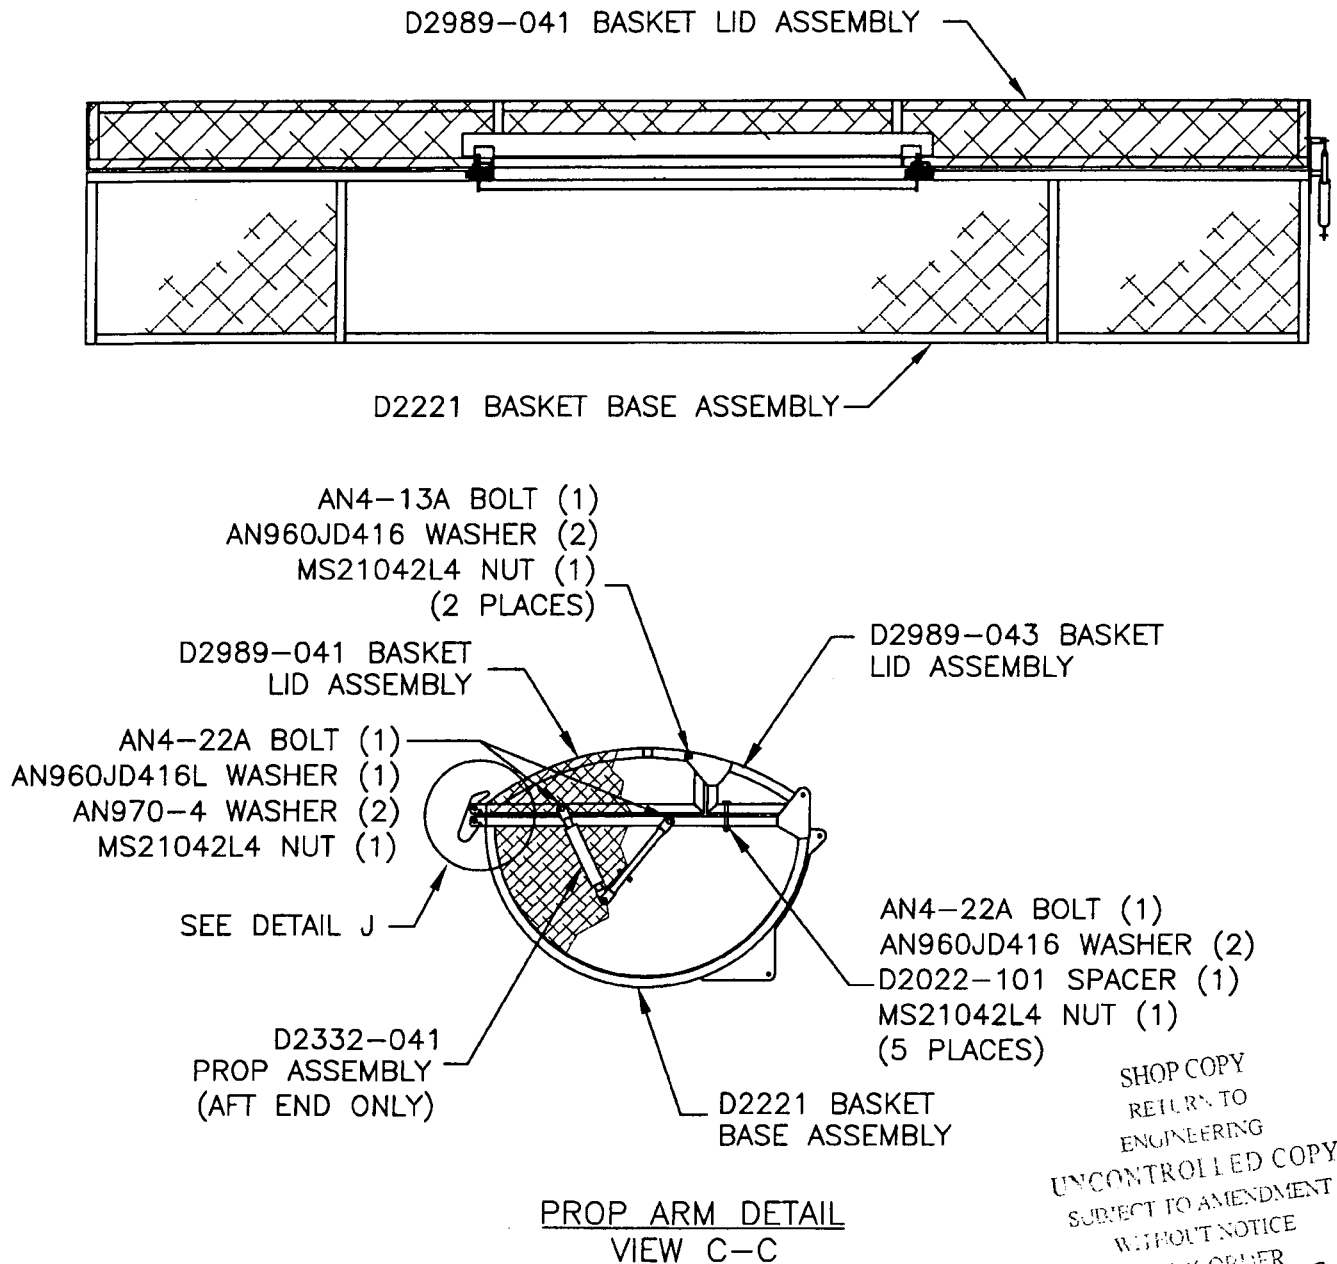


SHOP COPY  
RETURN TO  
ENGINEERING  
UNCONTROLLED COPY  
SUBJECT TO AMENDMENT  
WITHOUT NOTICE  
WORK ORDER  
NO. 37512

**Figure 5- Basket Replacement Parts**  
(D350-607-043 Heli-Utility-Basket™)


• COPYRIGHT © 1994 BY DART AEROSPACE LTD •  
THIS DOCUMENT IS PRIVATE AND CONFIDENTIAL AND IS SUPPLIED ON THE EXPRESS CONDITION THAT IT IS NOT TO BE USED FOR ANY PURPOSE OR COPIED OR COMMUNICATED TO ANY OTHER PERSON WITHOUT WRITTEN PERMISSION FROM DART AEROSPACE LTD.

Revision: **F**  
Date: 03.01.17



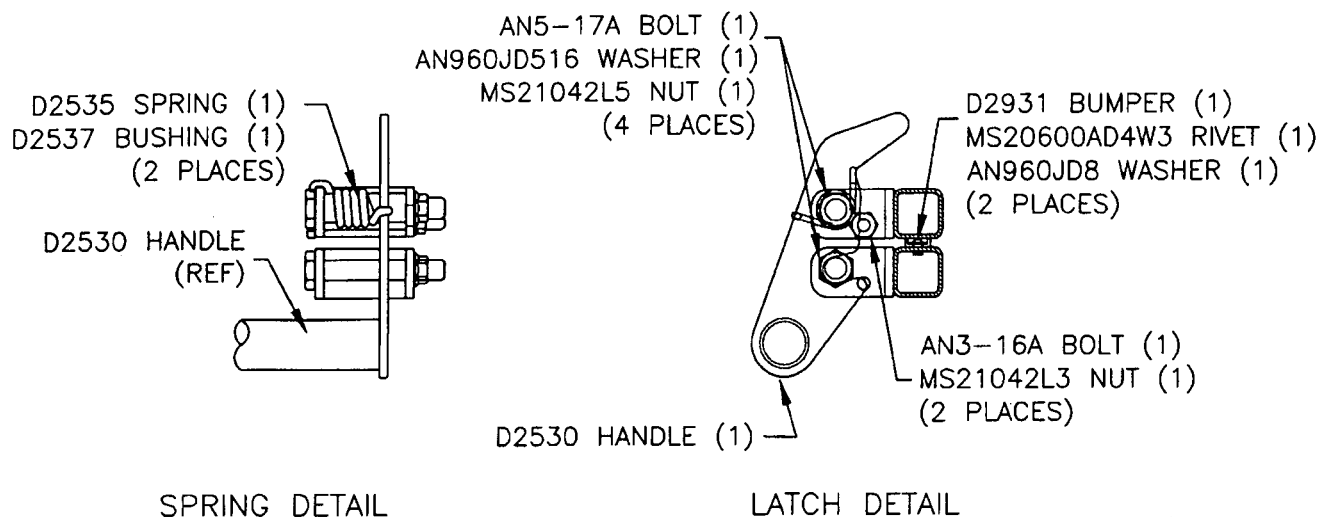

DETAIL J:  
HANDLE WELDMENT

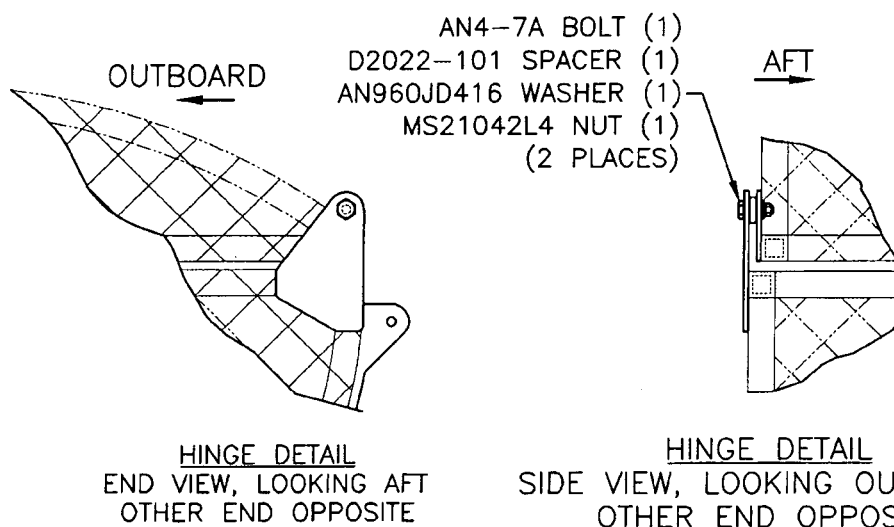

DETAIL H:  
HINGE

SHOP COPY  
RETURN TO  
ENGINEERING  
UNCONTROLLED COPY  
SUBJECT TO AMENDMENT  
WITHOUT NOTICE  
WORK ORDER  
NO. 37512

**Figure 6 – Basket Replacement Parts**

• COPYRIGHT © 1994 BY DART AEROSPACE LTD. •  
THIS DOCUMENT IS PRIVATE AND CONFIDENTIAL AND IS SUPPLIED ON THE EXPRESS CONDITION THAT IT IS NOT TO BE USED FOR ANY PURPOSE OR COPIED  
OR COMMUNICATED TO ANY OTHER PERSON WITHOUT WRITTEN PERMISSION FROM DART AEROSPACE LTD.

Revision: **F**  
Date: 03.01.17



DESIGN <i>CP</i>	DRAWN BY <i>CP</i>	DART AEROSPACE LTD HAWKESBURY, ONTARIO, CANADA	
CHECKED <i>[Signature]</i>	APPROVED <i>[Signature]</i>	DRAWING NO. DSI 9318	REV. A SHEET 1 OF 1
DATE 06.01.06		TITLE WASHER ADDITION	SCALE NTS
A	06.01.06	NEW ISSUE	

# DART SERVICE INSTRUCTION

TO AMEND INSTALLATION INSTRUCTIONS D350-607 REV. F

REF. CANADIAN STC: SH94-14 ISSUE 4


REF. FAA STC: SR00213NY

To reduce the possibility of damaging the finish, a **NAS1515H4** washer (2 places) has been added between the hinge plate and basket frame on the **D350-607-043/-047 Heli-Utility-Basket**.

The corrected bolt stackup from Figure 5 of installation instructions D350-607 Rev. F is given below:

AN4-13A BOLT (1)  
AN960JD416 WASHER (1)  
HINGE PLATE (REF)  
**NAS1515H4 WASHER (1)**  
BASKET FRAME (REF)  
AN960JD416 WASHER (1)  
MS21042L4 NUT (1)  
(2 PLACES)

BASKET FRAME (REF)      HINGE PLATE (REF)

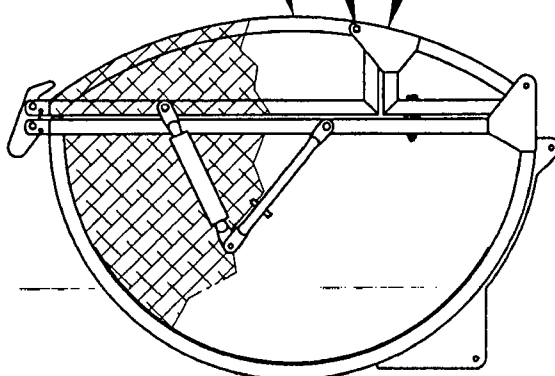

SHOP COPY  
RETURN TO  
ENGINEERING  
UNCONTROLLED COPY  
SUBJECT TO AMENDMENT  
WITHOUT NOTICE  
WORK ORDER  
NO. **37512**

CANADA DEPARTMENT OF TRANSPORT AIRCRAFT CERTIFICATION BRANCH DAO # 01-O-01	
APPROVED <i>[Signature]</i>	
BY:	D. SHEPHERD (DE #02)
DATE:	06.01.06
CERT. NO.:	SH94-14
ISSUE NO.:	4

Copyright © 2006 by DART AEROSPACE LTD

THIS DOCUMENT IS PRIVATE AND CONFIDENTIAL AND IS SUPPLIED ON THE EXPRESS CONDITION THAT IT IS NOT TO BE USED FOR ANY PURPOSE OR COPIED OR COMMUNICATED TO ANY OTHER PERSON WITHOUT WRITTEN PERMISSION FROM DART AEROSPACE LTD.

Wednesday, 2/20/2008 4:17:03 PM  
Kim Johnston

## Process Sheet

11

Customer	: CU-DAR001 Dart Helicopters Services	Drawing Name	: BASKET LID ASSEMBLY
Job Number	: 37512B		
Estimate Number	: 10207		
P.O. Number	:	Part Number	: D2989043
This Issue	: 2/20/2008 S.O. No. :	Drawing Number	: D2989 UNDER REVIEW
Prsht Rev.	: NC	Project Number	: N/A
First Issue	: 1/1 Type : LARGE FAB ASSY	Drawing Revision	: B
Previous Run	: 37511B	Material	:
Written By	:	Due Date	: 3/10/2008 Qty: 1 Um: Each
Checked & Approved By	: <u>080221</u>		
Comment	: Est Rev: Removed D2989-041 05-11-03 JLM		

## Additional Product

Job Number:



Seq. #:	Machine Or Operation:	Description :
---------	-----------------------	---------------

1.0	D31821	Hinge
-----	--------	-------



Comment: Qty.: 2.0000 Each(s)/Unit Total : 2.0000 Each(s)

Pick:

Qty Part number	Description	Batch
2 D3182-1	Hinge	<u>336483</u>

08.05.15

2.0	D34423	Shim
-----	--------	------



Comment: Qty.: 2.0000 Each(s)/Unit Total : 2.0000 Each(s)

Pick:

Qty Part number	Description	Batch
2 D3442-3	Shim	<u>337160</u>

08.05.15

3.0	M304EX07516F	Expanded Metal Flat Stai
-----	--------------	--------------------------



Comment: Qty.: 8.0000 sf(s)/Unit Total : 8.0000 sf(s)

Pick:

Qty Part number	Description	Batch
8sf M304EX0.75-16F Expanded Metal		<u>M107368</u>

~~M107368~~

SAD 08/05/14

D

4.0	M304TS0750W065	304 SQ Tube.75x.75x.065W
-----	----------------	--------------------------



Comment: Qty.: 17.6400 f(s)/Unit Total : 17.6400 f(s)

3/4" x 3/4" x 0.065" wall 304/316 SStubing.

Batch: ~~M107967~~ M107967

SAD 08/05/14

D

W/O:		WORK ORDER CHANGES					
DATE	STEP	PROCEDURE CHANGE	By	Date	Qty	Approval Chief Eng / Prod Mgr	Approval QC Inspector

Part No: \_\_\_\_\_ PAR #: \_\_\_\_\_ Fault Category: \_\_\_\_\_ NCR: Yes No DQA: \_\_\_\_\_ Date: \_\_\_\_\_

QA: N/C Closed: \_\_\_\_\_ Date: \_\_\_\_\_

NCR:		WORK ORDER NON-CONFORMANCE (NCR)						
DATE	STEP	Description of NC Section A	Corrective Action Section B			Verification Section C	Approval Chief Eng	Approval QC Inspector
			Initial Chief Eng	Action Description Chief Eng	Sign & Date			

NOTE: Date & initial all entries

Date: Wednesday, 2/20/2008 4:17:03 PM  
User: Kim Johnston

## Process Sheet

Customer: CU-DAR001 Dart Helicopters Services

Drawing Name: BASKET LID ASSEMBLY

Job Number: 375128

Part Number: D2989043

Job Number:



Seq. #:

Machine Or Operation:

Description :

5.0

LARGE FAB 1

LARGE FABRICATION RESOURCE 1



Comment: LARGE FABRICATION RESOURCE 1

1-Cut (4) D2236-1 From D3166-3 As Per Dwg D2989

Note: D2989-3/-4 On -041 Bom

SAD 08/05/14 (1)

2-Drill holes in tubing as D2989-043 per Dwg D2989

3-Deburr and remove all markings on material

4-Weld as per Dwg D2989 and D2989-043 Assembly using Welding Table and corner Jig. Deburr as required

Note: Expanded metal "diamonds" must run lengthwise. Eg 2.0" along length of lid

SS 08/05/21

08-05-20

6.0

QC9

VISUAL WELDING INSPECTION



Comment: VISUAL WELDING INSPECTION

08-05-22

7.0

QC6

DIMENSIONAL CHECK



Comment: DIMENSIONAL CHECK

08/05/22 (10)

30 min  
23/05/2008  
S.270  
#1 08.48  
#2 39.6 F  
#3 B37512B  
#4 D2989043

8.0

POWDER COATING

POWDER COATING



Comment: POWDER COATING

M107925

1-Powder Coat White (Ref. 4.3.5.2) D2989-041 as per QSI 005 4.3 & Dwg D2989

M-1

08-05-23

9.0

QC3

INSPECT POWDER COAT/CHEMICAL CONVERSION



Comment: Inspect Powder Coat

BL 08-05-23

10.0

QC21

FINAL INSPECTION/W/O RELEASE



Comment: FINAL INSPECTION/W/O RELEASE

08/05/23

Job Completion



MF 08-05-23

W/O:		WORK ORDER CHANGES					
DATE	STEP	PROCEDURE CHANGE	By	Date	Qty	Approval Chief Eng / Prod Mgr	Approval QC Inspector

Part No: \_\_\_\_\_ PAR #: \_\_\_\_\_ Fault Category: \_\_\_\_\_ NCR: Yes No DQA: \_\_\_\_\_ Date: \_\_\_\_\_

QA: N/C Closed: \_\_\_\_\_ Date: \_\_\_\_\_

NCR:		WORK ORDER NON-CONFORMANCE (NCR)						
DATE	STEP	Description of NC Section A	Corrective Action Section B			Verification Section C	Approval Chief Eng	Approval QC Inspector
			Initial Chief Eng	Action Description Chief Eng	Sign & Date			

**NOTE:** Date & initial all entries



DESIGN DS	DRAWN BY PH	DART AEROSPACE LTD HAWKESBURY, ONTARIO, CANADA	
CHECKED <i>[Signature]</i>	APPROVED <i>[Signature]</i>	DRAWING NO. D2989	REV. B SHEET 1 OF 3
DATE 05.06.07		TITLE BASKET LID ASSEMBLY	SCALE NTS
A	00.10.27	NEW ISSUE	
B	05.06.07	ADD SHIM UNDER HINGES, UPDATE LID DIMENSIONS	

RELEASED

05-08-19 *[Signature]*

PARTS LIST:

Qty -041	Qty -043	Part Number	Description
X		D2989-041	BASKET LID ASSEMBLY (OUTSIDE)
	X	D2989-043	BASKET LID ASSEMBLY (INSIDE)
	1	D2989-1	STRUT
	1	D2989-2	STRUT
	1	D2989-3	STRUT
	1	D2989-4	STRUT
	2	D2989-5	STRUT
	2	D2989-7	STRUT
1		D2989-9	STRUT
1		D2989-10	STRUT
1		D2989-11	STRUT
1		D2989-12	STRUT
2		D2989-13	STRUT
2		D2989-15	STRUT
2		D2327-3	SPACER BUSHING
1		D2506	LABEL PLATE
2	2	D2989-17	STRUT (96.00" LONG)
2		D2989-19	STRUT (31.19" LONG)
1		D2512-7	STRUT
2		D2581	MOUNTING BRACKET
	2	D3182-1	HINGE
	2	D3442-3	SHIM

UNDER REVIEW  
08-02-05 PH

TUBING TO BE  
CHANGED TO 0.065  
WALL PH  
03-02-21






SHOP COPY  
RETURN TO  
ENGINEERING  
UNCONTROLLED COPY  
SUBJECT TO AMENDMENT  
WITHOUT NOTICE  
WORK ORDER  
NO. 37512B

NOTES:

- 1) FRAME MATERIAL: AISI 304/316 SS, 3/4 x 3/4 x 0.060 WALL SQUARE TUBING  
D2989-3/4/5/11/12/13 CAN BE MADE FROM D2236
- 2) MESH MATERIAL: 3/4-16F EXPANDED SS (REF DART SPEC M304EX0.75-16F)
- 3) WELD PER DART QSI 004
- 4) FINISH: POWDER COAT WHITE (REF. 4.3.5.2) PER DART QSI 005 4.3.  
BLACK ANTI-SKID PAINT AS INDICATED PER DART QSI 005 4.4. SPRAY PAINT  
INSIDE SURFACE BLACK PRIOR TO APPLYING ANTI-SKID.
- 5) ALL DIMENSIONS ARE IN INCHES
- 5) TOLERANCES ARE PER DART QSI 018 UNLESS OTHERWISE NOTED

Copyright © 2000 by DART AEROSPACE LTD

THIS DOCUMENT IS PRIVATE AND CONFIDENTIAL AND IS SUPPLIED ON THE EXPRESS CONDITION THAT IT IS NOT TO BE USED FOR ANY PURPOSE OR COPIED OR COMMUNICATED TO ANY OTHER PERSON WITHOUT WRITTEN PERMISSION FROM DART AEROSPACE LTD.

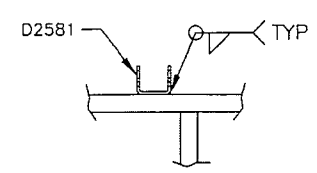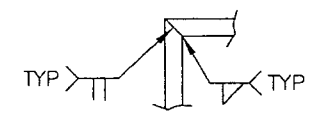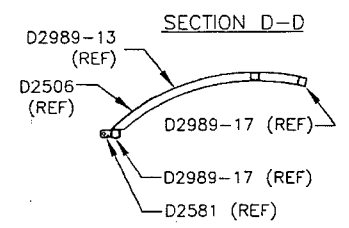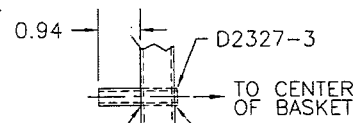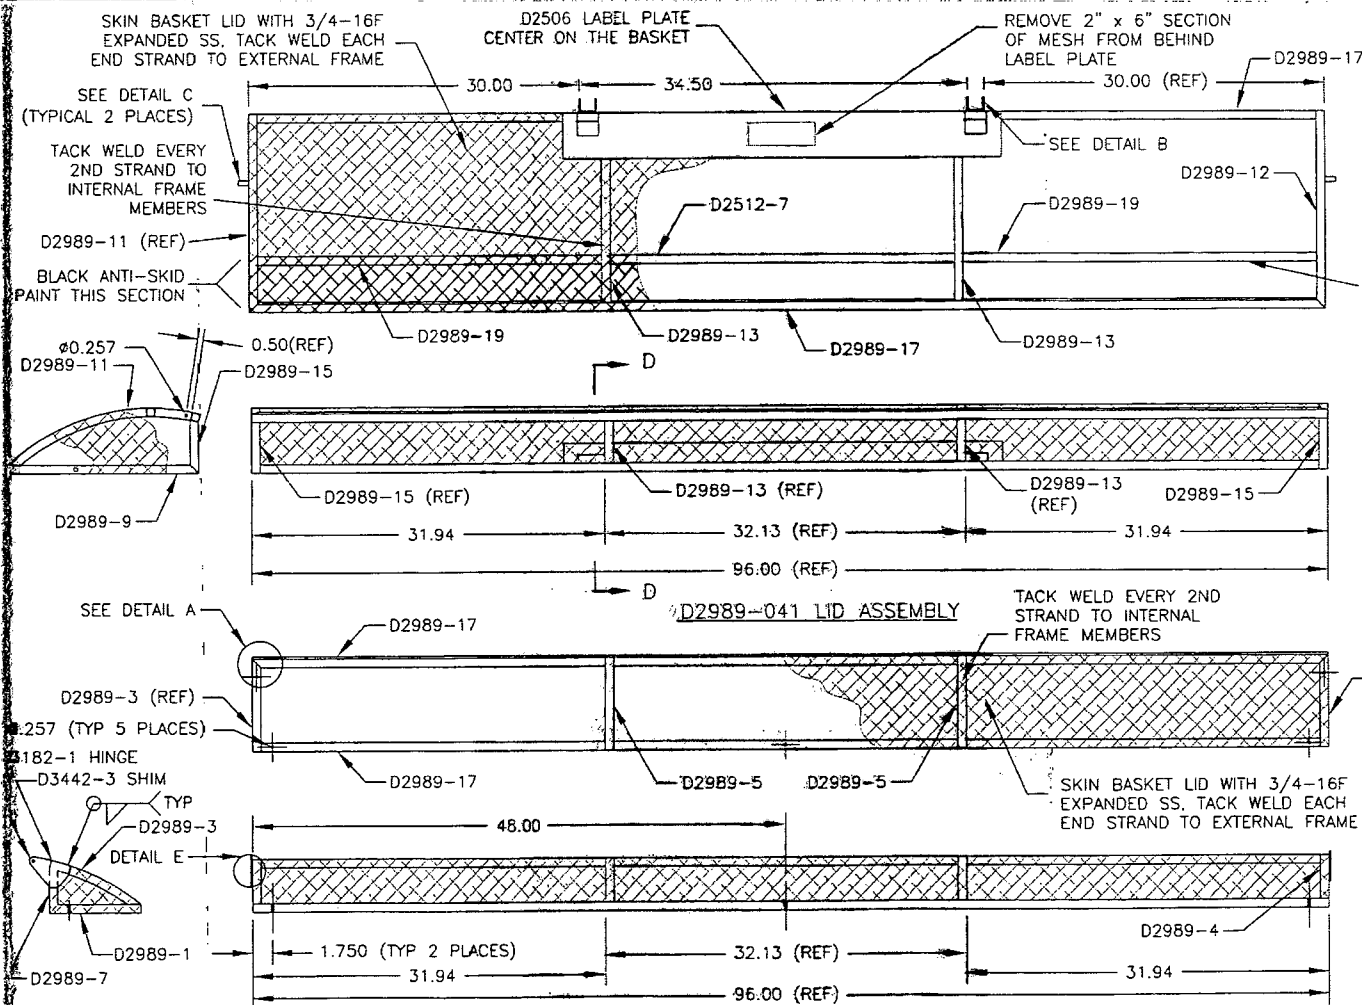

SEE DETAIL C  
(TYPICAL 2 PLACES)

TACK WELD EVERY  
2ND STRAND TO  
INTERNAL FRAME  
MEMBERS

D2989-11 (REF)

BLACK ANTI-SKID  
PAINT THIS SECTION

0.257

D2989-11

0.50(REF)

D2989-15

D2989-9

D2989-17

D2989-13 (REF)

D2989-13 (REF)

D2989-13 (REF)

D2989-15

D2989-17

D2989-17

UNDER REVIEW

TUBING TO BE  
CHANGED TO 0.50


08.02.21

NO. 37512B  
WORLD ORDER  
UNCONTROLLED COPY  
ENGINEERING  
RETURN TO  
SUBJECT TO AMENDMENT  
WITHOUT NOTICE

COPYRIGHT © 2000 BY DART AEROSPACE LTD.		DESIGN	DS	DRAWN BY	PH	<b>DART</b> DART AEROSPACE LTD. WARRICKS, ONTARIO, CANADA	REV. B SHEET 2 OF 3 SCALE 1:10
THIS DOCUMENT IS PRIVATE AND CONFIDENTIAL AND IS SUPPLIED ON THE EXPRESS CONDITION THAT IT IS NOT TO BE USED FOR ANY PURPOSE OR COPIED OR COMMUNICATED TO ANY OTHER PERSON WITHOUT WRITTEN PERMISSION FROM DART AEROSPACE LTD.		CHECKED	#	APPROVED	#		
		DATE	05.06.07	DRAWING NO.		D2989	
				TITLE		BASKET LID ASSEMBLY	






RELEASED  
05-08-11



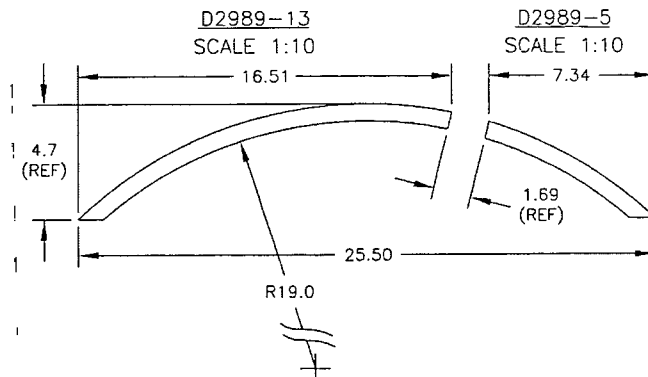

D2989-15  
SCALE 2:5  
(DIMENSIONS LISTED AS REFERENCE ONLY, CUT TO FIT ASSEMBLY)

D2989-7  
SCALE 2:5  
(DIMENSIONS LISTED AS REFERENCE ONLY, CUT TO FIT ASSEMBLY)

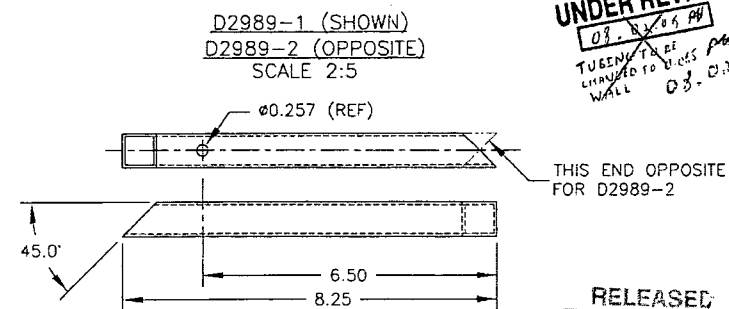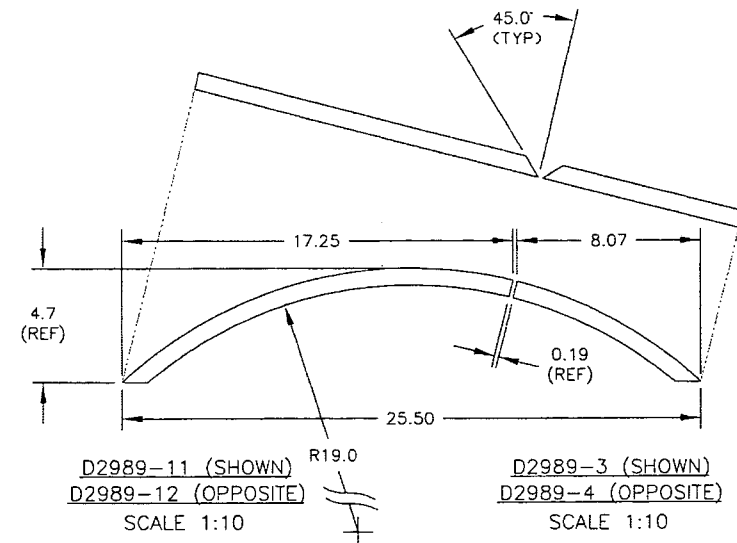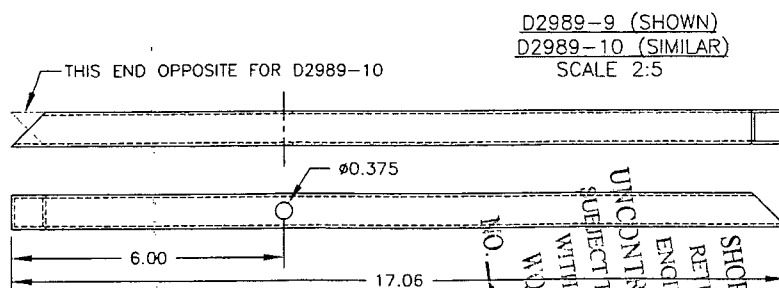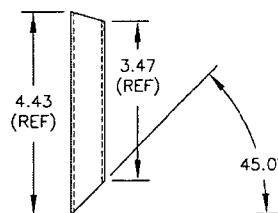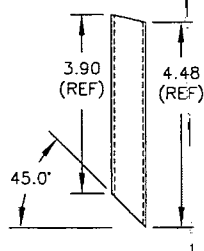

COPYRIGHT © 2000 BY DART AEROSPACE LTD.		DESIGN	DS	DRAWN BY	PH	<b>DART</b>	DART AEROSPACE LTD. HAMPSHIRE, ONTARIO, CANADA
THIS DOCUMENT IS PRIVATE AND CONFIDENTIAL AND IS SUPPLIED ON THE EXPRESS CONDITION THAT IT IS NOT TO BE USED FOR ANY PURPOSE OR COPIED OR COMMUNICATED TO ANY OTHER PERSON WITHOUT WRITTEN PERMISSION FROM DART AEROSPACE LTD.		CHECKED	PH	APPROVED	PH	DRAWING NO.	REV. B
		DATE	05.06.07			D2989	SHEET 3 OF 3
		TITLE	BASKET LID ASSEMBLY				SCALE 1:10

NO. 37512B

WORK ORDER

SUBJECT TO AMENDMENT WITHOUT NOTICE

UNCONTROLLED COPY

ENGINEERING

RETURN TO

SHOP COPY

Date: Wednesday, 2/20/2008 4:17:12 PM  
 User: Kim Johnston

## Process Sheet

Customer : CU-DAR001 Dart Helicopters Services Drawing Name : BASKET BASE ASSEMBLY (350)  
 Job Number : 37512C  
 Estimate Number : 10189  
 P.O. Number :  
 This Issue : 2/20/2008 S.O. No. :  
 Prsht Rev. : NC Part Number : D2221  
 First Issue : 1/1 Type : LARGE FAB ASSY Drawing Number : D2221 U/R, D2235  
 Previous Run : 37511C Drawing Revision : F/B1  
 Material :  
 Due Date : 3/10/2008 Qty: 1 Um: Each  
 Written By :  
 Checked & Approved By :  
 Comment : Est Rev: 05.09.02 Added D3442-1 KJ/JLM

## Additional Product

Job Number:



Seq. #: Machine Or Operation: Description :

1.0 D31661 Basket Hoop



Comment: Qty.: 4.0000 Each(s)/Unit Total : 4.0000 Each(s)

Pick:

Qty Part Number Description Batch

4 D3166-1 RIB B39048 ✓

SAD 08/05/15

2.0 D22323 Basket Hinge



Comment: Qty.: 2.0000 Each(s)/Unit Total : 2.0000 Each(s)

Pick:

Qty Part Number Description Batch

2 D2232-3 Hinge bracket B36846 ✓

SJ 08/05/15

3.0 D2325 Support Gusset (350 Bask



Comment: Qty.: 4.0000 Each(s)/Unit Total : 4.0000 Each(s)

Pick:

Qty Part Number Description Batch

4 D2325 Support Gusset B37447 ✓

SJ 08/05/15

4.0 D23273 Spacer Bushing



Comment: Qty.: 2.0000 Each(s)/Unit Total : 2.0000 Each(s)

Pick:

Qty Part Number Description Batch

2 D2327-3 Bushing B37851 ✓

SJ 08/05/15

W/O:		WORK ORDER CHANGES					
DATE	STEP	PROCEDURE CHANGE	By	Date	Qty	Approval Chief Eng / Prod Mgr	Approval QC Inspector

Part No: \_\_\_\_\_ PAR #: \_\_\_\_\_ Fault Category: \_\_\_\_\_ NCR: Yes No DQA: \_\_\_\_\_ Date: \_\_\_\_\_

QA: N/C Closed: \_\_\_\_\_ Date: \_\_\_\_\_

NCR:		WORK ORDER NON-CONFORMANCE (NCR)						
DATE	STEP	Description of NC Section A	Corrective Action Section B			Verification Section C	Approval Chief Eng	Approval QC Inspector
			Initial Chief Eng	Action Description Chief Eng	Sign & Date			

**NOTE:** Date & initial all entries

Date: Wednesday, 2/20/2008 4:17:13 PM  
User: Kim Johnston

## Process Sheet

Customer: CU-DAR001 Dart Helicopters Services

Drawing Name: BASKET BASE ASSEMBLY (350)

Job Number: 37512C

Part Number: D2221

Job Number:



Seq. #:	Machine Or Operation:	Description :
---------	-----------------------	---------------

5.0	D2581	Mounting Bracket
-----	-------	------------------



Comment: Qty.: 2.0000 Each(s)/Unit Total : 2.0000 Each(s)

Pick:

Qty Part Number Description Batch

2 D2581 Mounting Bracket B 37248 ✓

*JS* 08/05/15

6.0	D34421	Shim
-----	--------	------



Comment: Qty.: 2.0000 Each(s)/Unit Total : 2.0000 Each(s)

Pick:

Qty Part Number Description Batch

2 D3442-1 Shim

B 37615 ✓

*JS* 08/05/15

7.0	M304EX07516F	Expanded Metal Flat Stai
-----	--------------	--------------------------



Comment: Qty.: 41.6745 sf(s)/Unit Total : 41.6745 sf(s)

Pick:

Qty Part Number Description Batch

39.69 sf M304EX0.75-16F Expanded Metal

M107368

*SAD* 08/05/14

8.0	M304TS0750W065	304 SQ Tube 75x 75x .065W
-----	----------------	---------------------------



Comment: Qty.: 29.4000 f(s)/Unit Total : 29.4000 f(s)

Pick:

28' 3/4" x 3/4" x ~~0.063~~ wall 304/316 SStubing

Batch: M107967

0.055 *JS* 08-02-21

*SAD* 08/05/14

9.0	LARGE FAB 1	LARGE FABRICATION RESOURCE 1
-----	-------------	------------------------------



Comment: LARGE FABRICATION RESOURCE 1

1-Cut D2235-1 Rib from D3166-1 Rib As Per Dwg D2235

2-Drill hole in D2221-3 as per Dwg D2221 ✓

3-Deburr ✓

4-Remove all markings on material before welding ✓

5-Weld as per Dwg D2221 using Welding Table and corner JigDeburr as required

*SAD* 08/05/14

*JS* 08/05/21

*JS* 08-05-20

W/O:		WORK ORDER CHANGES					
DATE	STEP	PROCEDURE CHANGE	By	Date	Qty	Approval Chief Eng / Prod Mgr	Approval QC Inspector

Part No: \_\_\_\_\_ PAR #: \_\_\_\_\_ Fault Category: \_\_\_\_\_ NCR: Yes No DQA: \_\_\_\_\_ Date: \_\_\_\_\_

QA: N/C Closed: \_\_\_\_\_ Date: \_\_\_\_\_

NCR:		WORK ORDER NON-CONFORMANCE (NCR)						
DATE	STEP	Description of NC Section A	Corrective Action Section B			Verification Section C	Approval Chief Eng	Approval QC Inspector
			Initial Chief Eng	Action Description Chief Eng	Sign & Date			

NOTE: Date & initial all entries

Date: Wednesday, 2/20/2008 4:17:13 PM  
User: Kim Johnston

## Process Sheet

Customer: CU-DAR001 Dart Helicopters Services

Drawing Name: BASKET BASE ASSEMBLY (350)

Job Number: 37512C

Part Number: D2221

Job Number:



Seq. #:

Machine Or Operation:

Description :

10.0

QC9

VISUAL WELDING INSPECTION



Comment: VISUAL WELDING INSPECTION

PD 08-05-22

11.0

QC6

DIMENSIONAL CHECK



Comment: DIMENSIONAL CHECK

S 08/05/22 (C)

30 min  
23/05/2008

12.0

POWDER COATING

POWDER COATING



Comment: POWDER COATING

Powder Coat White Gloss (Ref: 4.3.5.1) as per QSI 005 4.3

M 107925

08/05/22

S.271 09.14  
#1 397.5  
#2 B37512C  
#3 D2221  
#4

13.0

QC3

INSPECT POWDER COAT/CHEMICAL CONVERSION



Comment: INSPECT POWDER COAT/CHEMICAL CONVERSION

BR 08-05-23

14.0

QC21

FINAL INSPECTION/W/O RELEASE



Comment: FINAL INSPECTION/W/O RELEASE

08/05/23

Job Completion








MF 08-05-23

# Dart Aerospace Ltd

W/O:		WORK ORDER CHANGES					
DATE	STEP	PROCEDURE CHANGE	By	Date	Qty	Approval Chief Eng / Prod Mgr	Approval QC Inspector

Part No: \_\_\_\_\_ PAR #: \_\_\_\_\_ Fault Category: Large Fab. NCR: Yes No DQA: \_\_\_\_\_ Date: \_\_\_\_\_

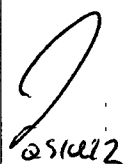QA: N/C Closed: \_\_\_\_\_ Date: \_\_\_\_\_

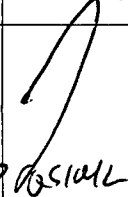NCR:		WORK ORDER NON-CONFORMANCE (NCR)						
DATE	STEP	Description of NC Section A	Corrective Action Section B			Verification Section C	Approval Chief Eng	Approval QC Inspector
			Initial Chief Eng	Action Description Chief Eng	Sign & Date			
08-05-22	11-0	open inspection it was found the handle clevis's were 0.5" off center, but even with the lid. Basket opens & closes. R.C. Lack of Attention.	 08/05/22	no handle interference. acceptable. Employee to be more cautious.	 08-05-22	 08/05/22	 08/05/22	 08-05-22

NOTE: Date & initial all entries




DESIGN BW	DRAWN BY PH	DART AEROSPACE LTD HAWKESBURY, ONTARIO, CANADA	
CHECKED <i>[Signature]</i>	APPROVED <i>[Signature]</i>	DRAWING NO. D2221	REV. F SHEET 1 OF 3
DATE 05.06.07		TITLE BASKET BASE ASSEMBLY (350)	SCALE NTS
C	95.11.21	SEPARATE BASKET AND LID	
D	96.06.21	CHANGE LATCH	
E	01.04.19	CHANGE HINGE	
F	05.06.07	ADD SHIM UNDER HINGES, ADD HOLES FOR SPLIT LID BASKETS	

RELEASED

05.08.19 *[Signature]*

PARTS LIST FOR D2221 BASKET BASE ASSEMBLY

PART NO	QUANTITY	LENGTH A	LENGTH B	DESCRIPTION
D2221-1	2	—	96.00	RIB
D2221-3	2	—	25.50	RIB
D2221-5	2	18.88	—	RIB
D2221-7	1	55.25	—	RIB
D2232-3	2	N/A	N/A	HINGE PLATE
D2235-1	4	N/A	N/A	RIB
D2325	4	N/A	N/A	SUPPORT GUSSET
D2327-3	2	N/A	N/A	BUSHING
D2581	2	N/A	N/A	MTG BRKT
D3442-1	2	N/A	N/A	SHIM

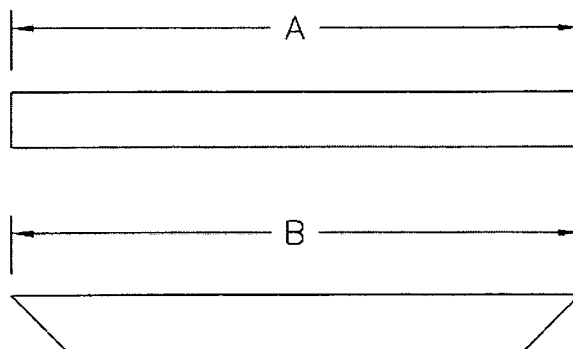

**UNDER REVIEW**

**UNCONTROLLED COPY**  
SUBJECT TO AMENDMENT  
WITHOUT NOTICE  
WORK ORDER  
NO. 37512C

D2221-1/-3/-5/-7

- 1) CUT LENGTH/SHAPE PER DIAGRAM AND PARTS LIST
- 2) MATERIAL: AISI 304/316 SS, 3/4 X 3/4 X 0.060 WALL SQUARE TUBING  
(REF. DART SPEC M304TS0.750W.060)
- 3) TOLERANCES ARE PER DART QSI 018 UNLESS OTHERWISE NOTED
- 4) ALL DIMENSIONS ARE IN INCHES
- 5) DRILL  $\phi 0.257$  HOLES ONLY WHEN ASSEMBLING D2221 BASE WITH D2989-041/-043 BASKET LID


Copyright © 1994 by DART AEROSPACE LTD

THIS DOCUMENT IS PRIVATE AND CONFIDENTIAL AND IS SUPPLIED ON THE EXPRESS CONDITION THAT IT IS NOT TO BE USED FOR ANY PURPOSE OR COPIED OR COMMUNICATED TO ANY OTHER PERSON WITHOUT WRITTEN PERMISSION FROM DART AEROSPACE LTD.





DESIGN	BW	DRAWN BY	PH	DART AEROSPACE LTD	
		HAWKESBURY, ONTARIO, CANADA			
CHECKED	<i>[Signature]</i>	APPROVED	<i>[Signature]</i>	DRAWING NO.	REV. F
DATE	05.06.07	TITLE	D2221	SHEET 2 OF 3	
BASKET BASE ASSEMBLY (350)				SCALE	1:20

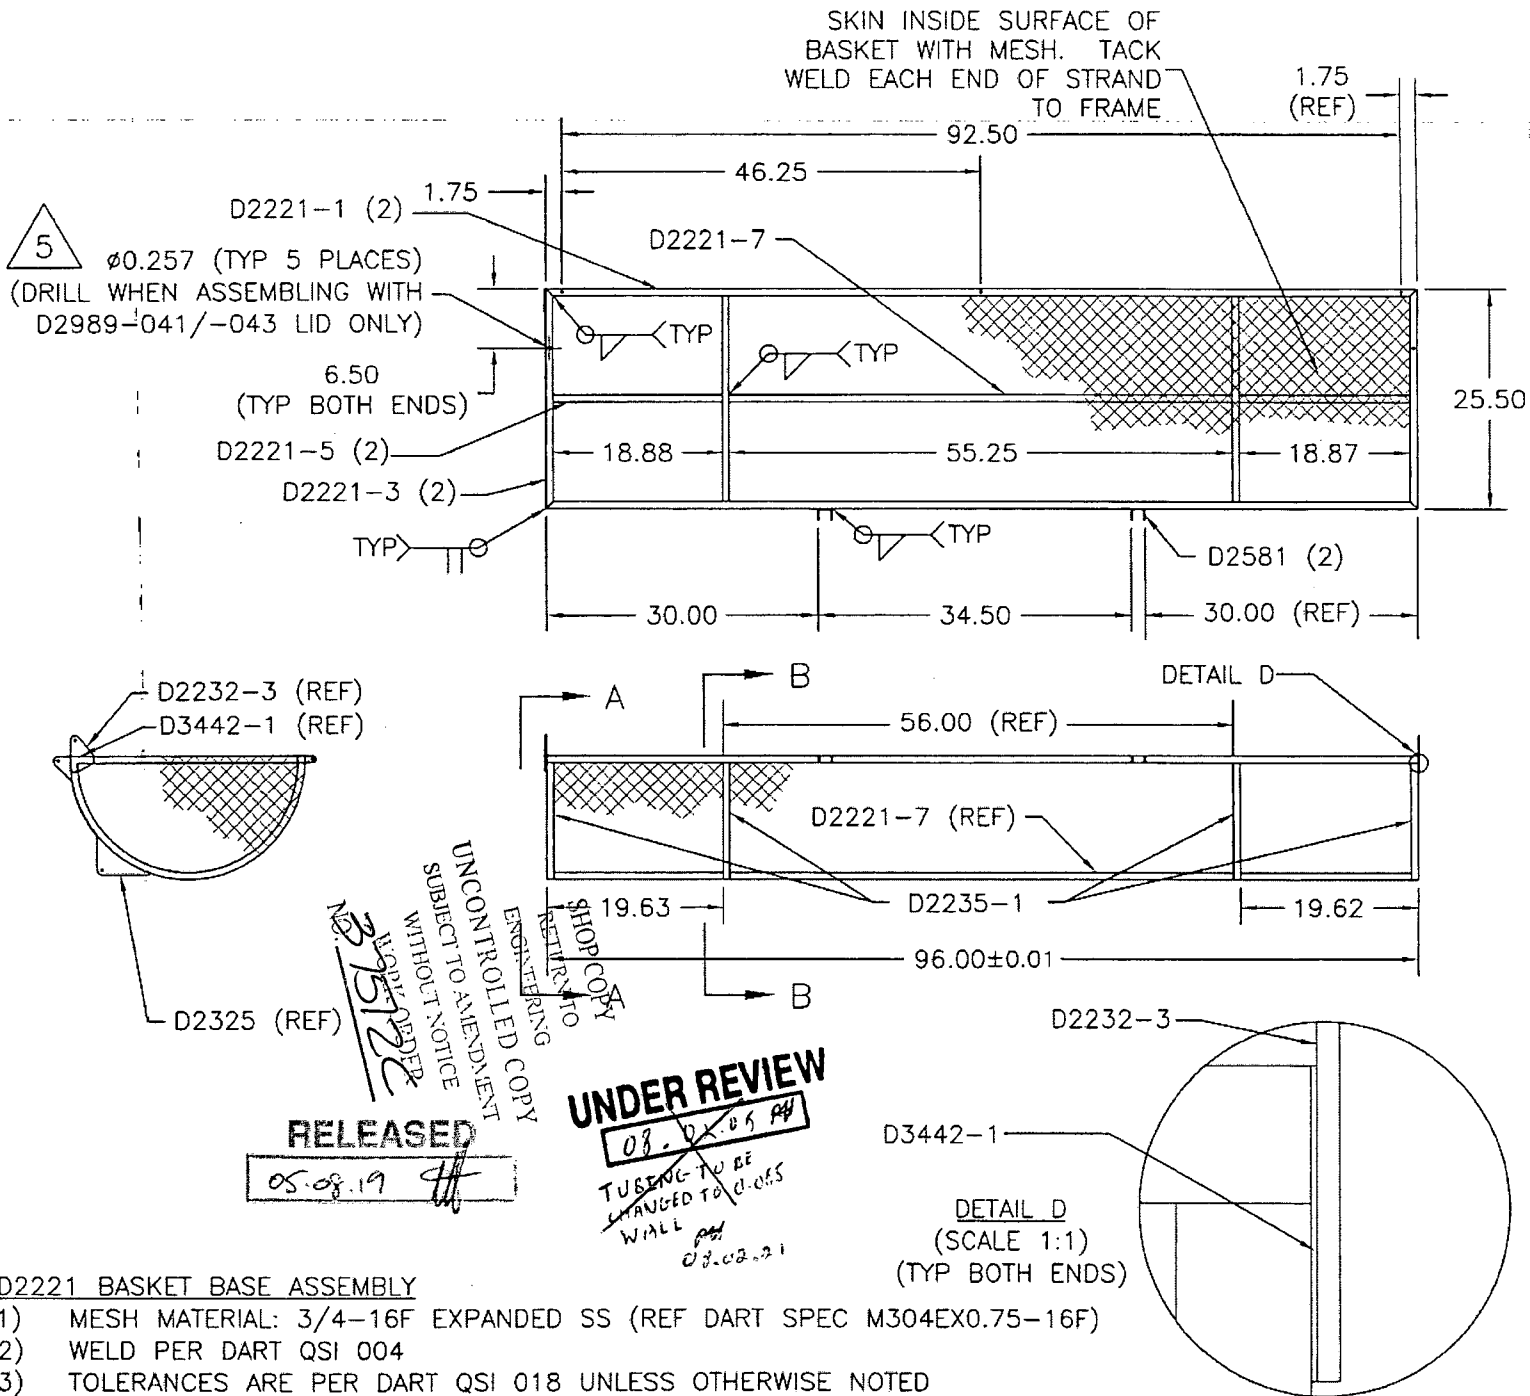


#### D2221 BASKET BASE ASSEMBLY

- 1) MESH MATERIAL: 3/4-16F EXPANDED SS (REF DART SPEC M304EX0.75-16F)
- 2) WELD PER DART QSI 004
- 3) TOLERANCES ARE PER DART QSI 018 UNLESS OTHERWISE NOTED
- 4) FINISH: POWDER COAT ENTIRE ASSEMBLY WHITE (4.3.5.2) PER DART QSI 005 4.3





DESIGN BW	DRAWN BY PH	DART AEROSPACE LTD HAWKESBURY, ONTARIO, CANADA	
CHECKED [Signature]	APPROVED [Signature]	DRAWING NO. D2221	REV. F SHEET 3 OF 3
DATE 05.06.07	TITLE BASKET BASE ASSEMBLY (350)		SCALE 1:8

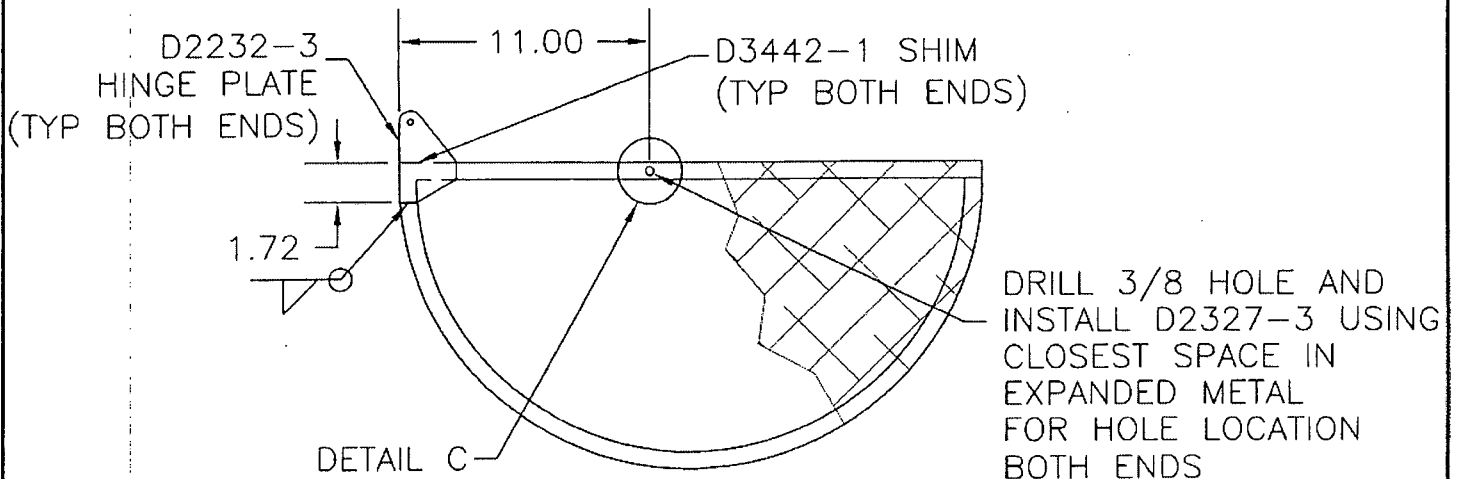

SECTION A-A SAME BOTH END RIBS

**UNDER REVIEW**

08.02.05 PH  
TUBING TO BE  
CHANGED TO 0.065  
WALL  
08.02.05

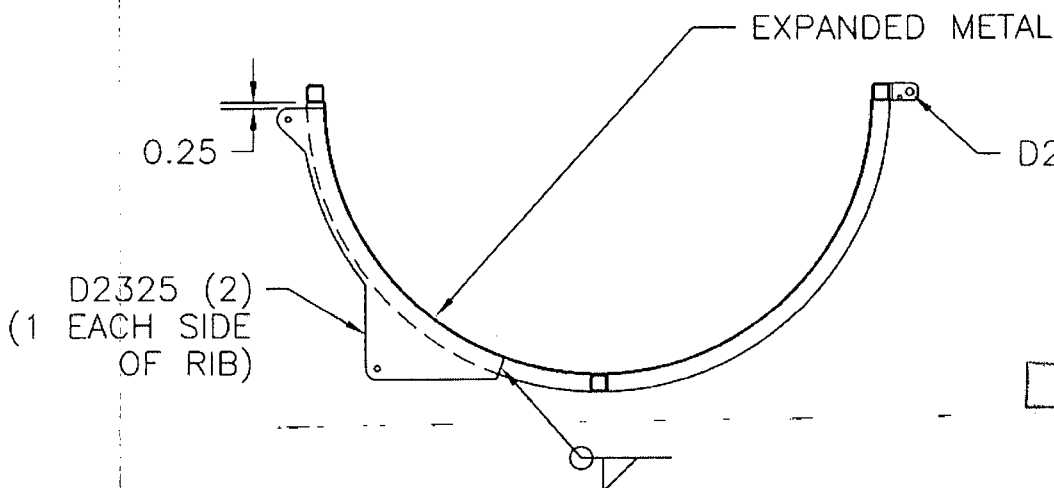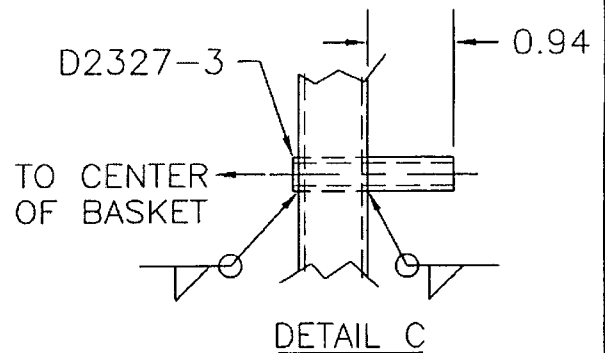

SHOP COPY  
RETURN TO  
ENGINEERING  
UNCONTROLLED COPY  
SUBJECT TO AMENDMENT  
WITHOUT NOTICE  
WORK ORDER  
NO. 37512

**RELEASED**

05.08.19 [Signature]

SECTION B-B SAME BOTH CENTER RIBS


Copyright © 1994 by DART AEROSPACE LTD

THIS DOCUMENT IS PRIVATE AND CONFIDENTIAL AND IS SUPPLIED ON THE EXPRESS CONDITION THAT IT IS NOT TO BE USED FOR ANY PURPOSE OR COPIED OR COMMUNICATED TO ANY OTHER PERSON WITHOUT WRITTEN PERMISSION FROM DART AEROSPACE LTD.




DESIGN	DRAWN BY	DART AEROSPACE LTD	
B WILLIAMS	B WILLIAMS	VICTORIA INTERNATIONAL AIRPORT, CANADA	
CHECKED	APPROVED	DRAWING NO.	REV. B
<i>[Signature]</i>	<i>[Signature]</i>	D2235	SHEET 1 OF 1
DATE	TITLE		SCALE
94:12:16	BASKET RIBS		
BI	02.08.06 <i>[Signature]</i>	CAN BE MADE FROM D3166-1	

RELEASED  
R 960507

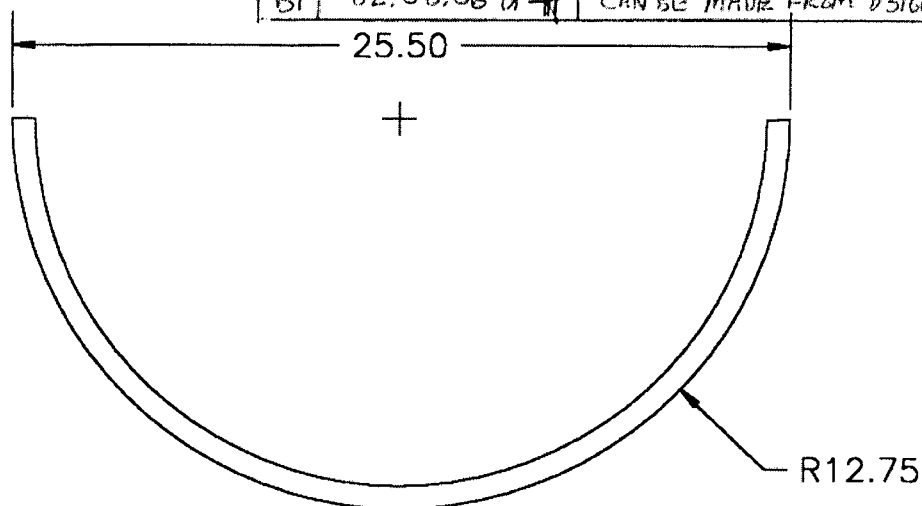


D2235-1

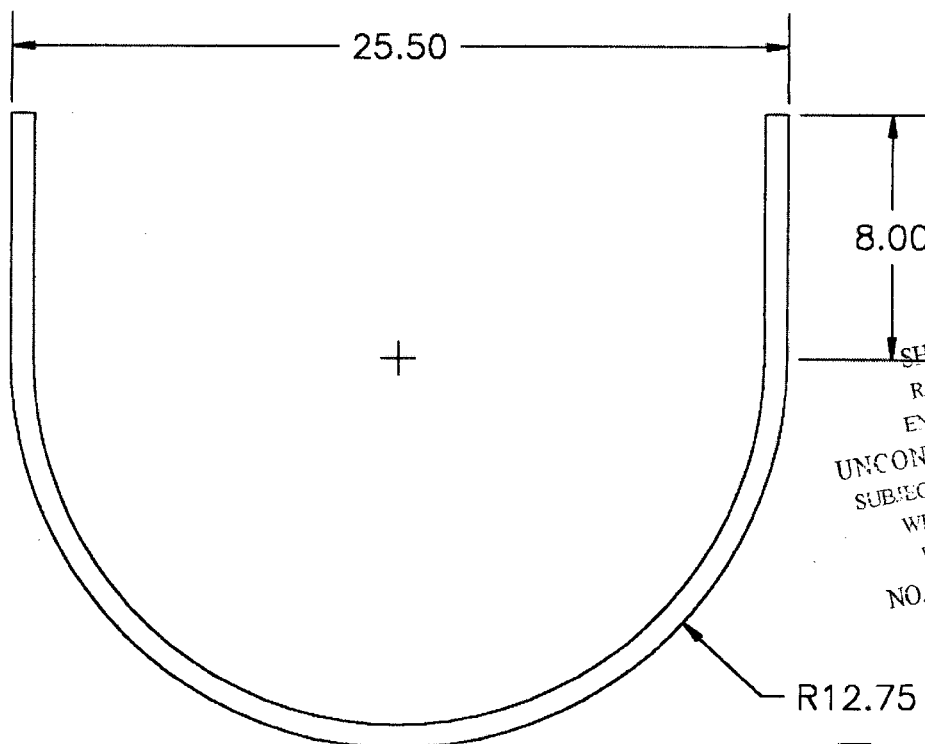

D2235-3

SHOP COPY  
RETURN TO  
ENGINEERING  
UNCONTROLLED COPY  
SUBJECT TO AMENDMENT  
WITHOUT NOTICE  
WORK ORDER  
NO. 37512C

CAN BE MADE FROM D3166-1 *[BI]*  
MATERIAL: 304/316 SS, 3/4 X 3/4 X 0.063 WALL SQR.

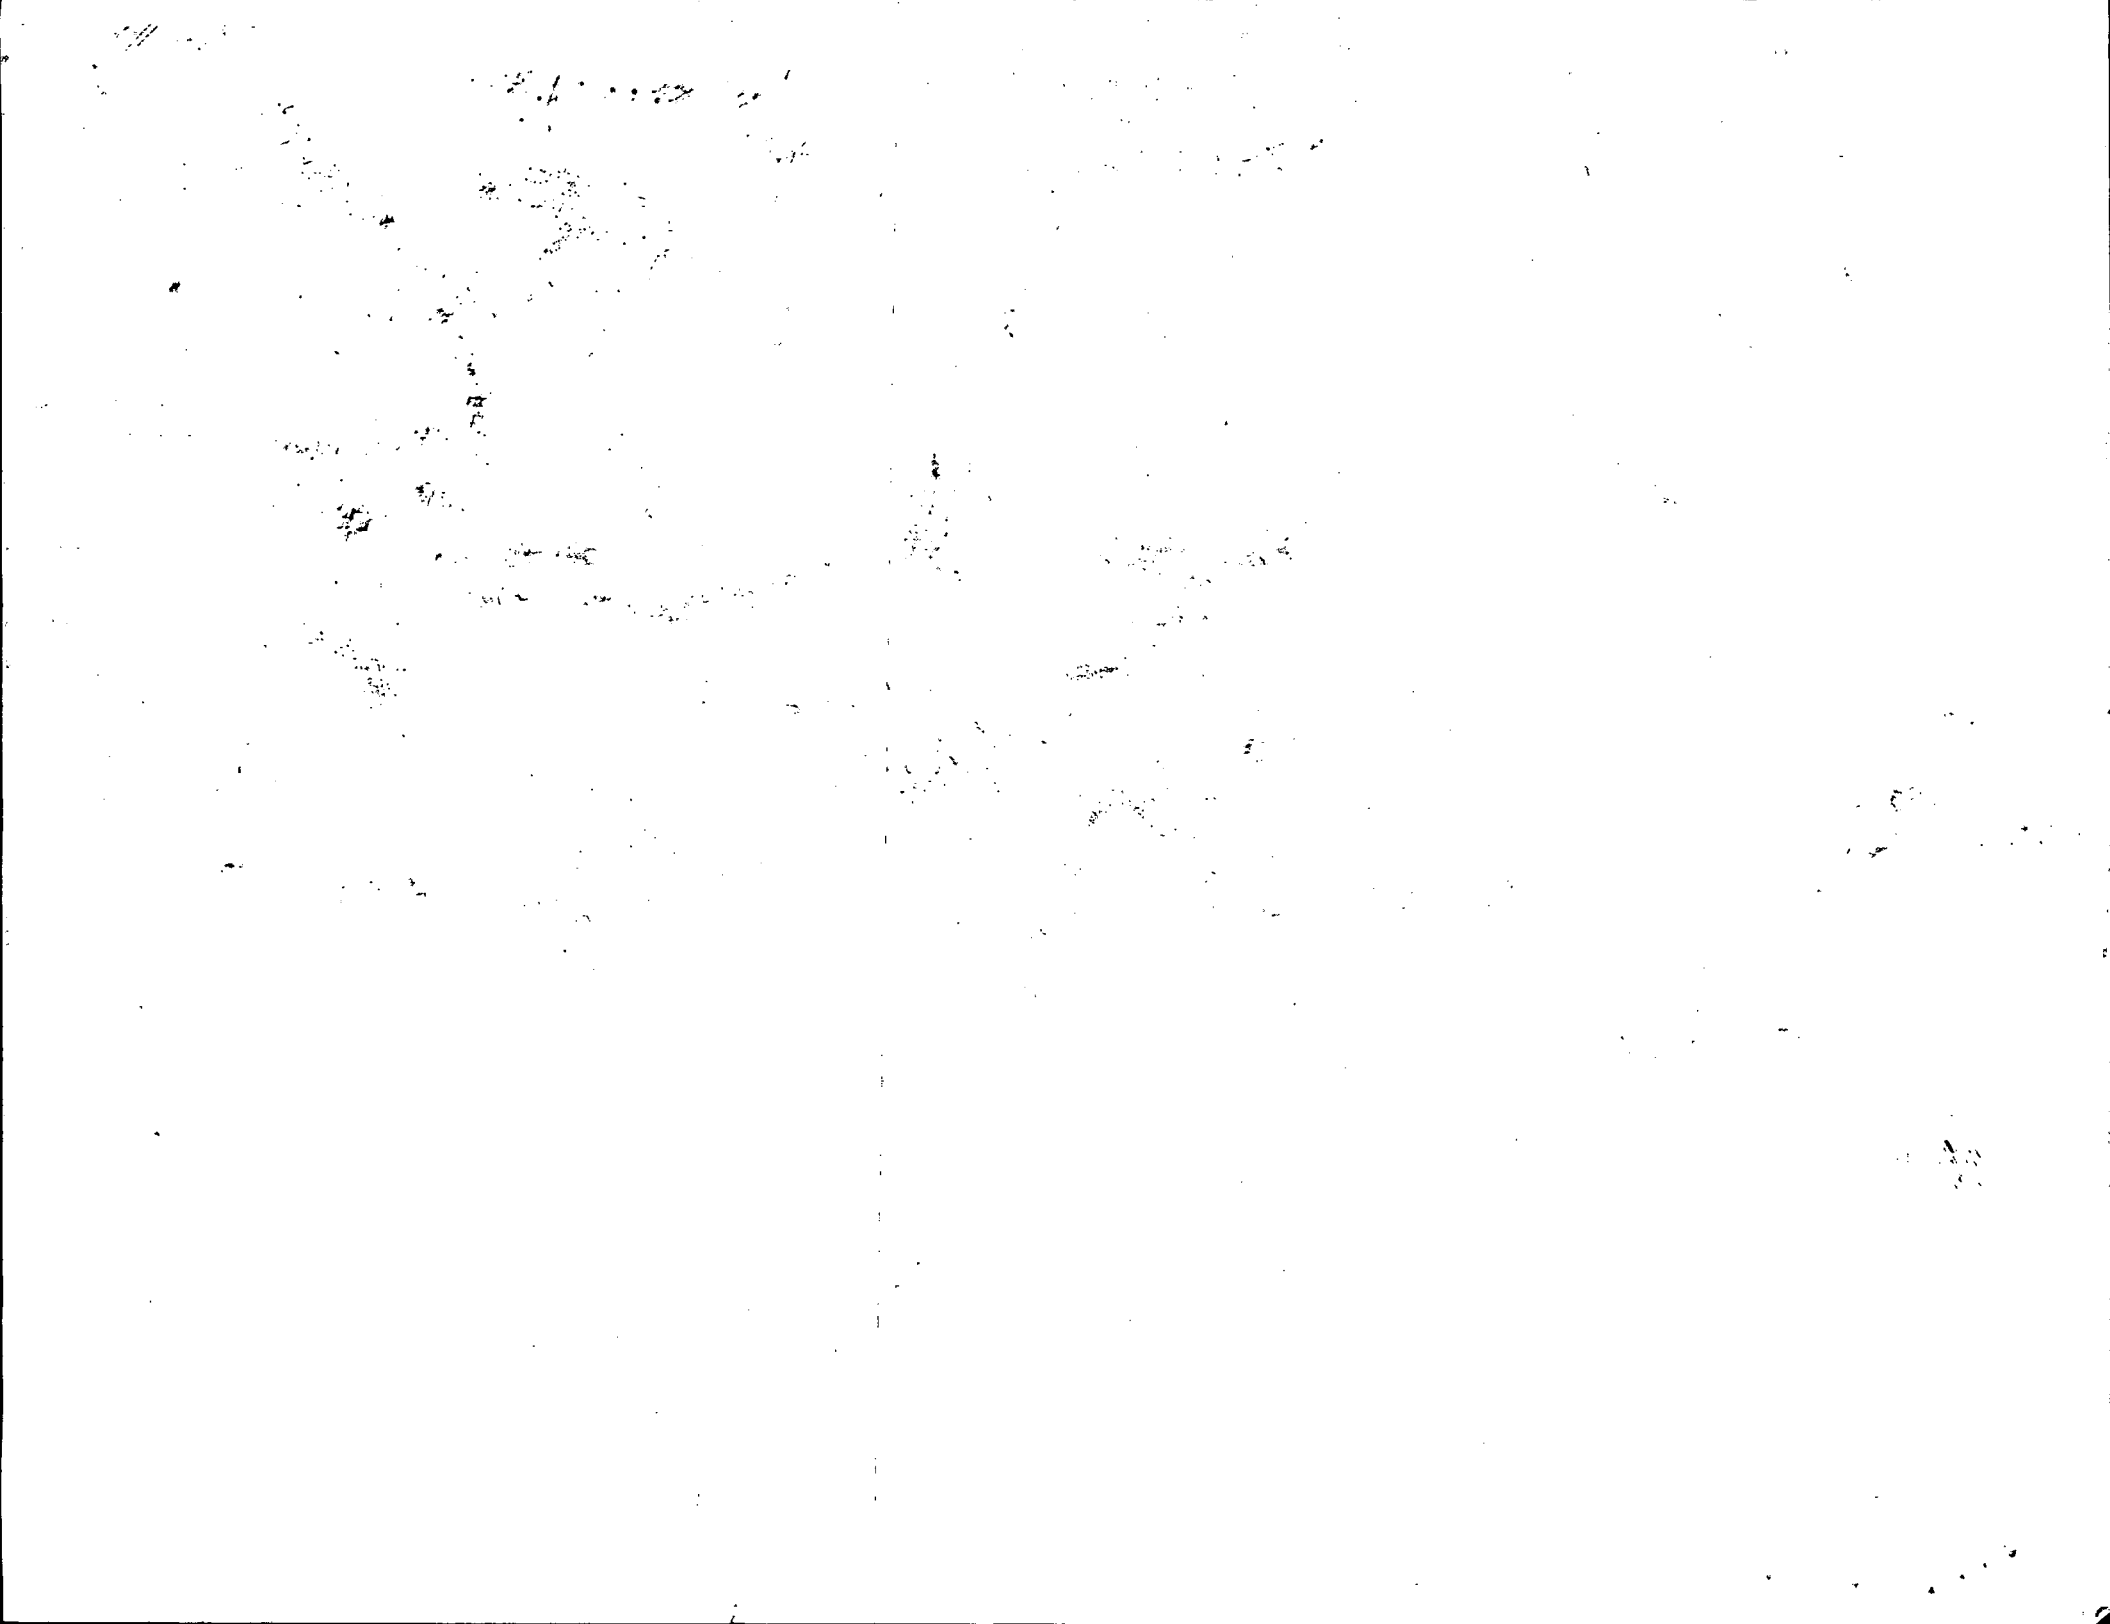

Date: Wednesday, 2/20/2008 4:16:58 PM  
 User: Kim Johnston

## Process Sheet

Customer	: CU-DAR001 Dart Helicopters Services	Drawing Name	: BASKET LID ASSEMBLY
Job Number	: 37512A		
Estimate Number	: 10206		
P.O. Number	:	Part Number	: D2989041
This Issue	: 2/20/2008 S.O. No. :	Drawing Number	: D2989 UNDER REVIEW
Prsht Rev.	: NC	Project Number	: N/A
First Issue	: 1/1 Type : LARGE FAB ASSY	Drawing Revision	: B
Previous Run	: 37511A	Material	:
Written By	:	Due Date	: 3/10/2008 Qty: 1 Um: Each
Checked & Approved By	: <u>JA 08 02 21</u>		
Comment	: Est Rev:1 Removed D2989-043 05-11-03 JLM		

## Additional Product

Job Number:



Seq. #:	Machine Or Operation:	Description :
---------	-----------------------	---------------

1.0	D31663	Basket Hoop
-----	--------	-------------



Comment: Qty.: 1.0000 Each(s)/Unit Total : 1.0000 Each(s)

Pick:

Qty.(1) D3166-3 Batch: ~~337248~~ 36860

SAD 08/05/15

①

2.0	D2581	Mounting Bracket
-----	-------	------------------



Comment: Qty.: 2.0000 Each(s)/Unit Total : 2.0000 Each(s)

Pick:

Qty Part number Description Batch

2 D2581 Mounting Brackets 337248

Plc 08.05.15

3.0	D23273	Spacer Bushing
-----	--------	----------------



Comment: Qty.: 2.0000 Each(s)/Unit Total : 2.0000 Each(s)

Pick:

Qty Part number Description Batch

2 D2327-3 Bushing 337851

Plc 08.05.15

4.0	D2506	Placard
-----	-------	---------



Comment: Qty.: 1.0000 Each(s)/Unit Total : 1.0000 Each(s)

Pick:

Qty Part number Description Batch

1 D2506 Label Plate 337446

Plc 08.05.15

W/O:		WORK ORDER CHANGES					
DATE	STEP	PROCEDURE CHANGE	By	Date	Qty	Approval Chief Eng / Prod Mgr	Approval QC Inspector

Part No: \_\_\_\_\_ PAR #: \_\_\_\_\_ Fault Category: \_\_\_\_\_ NCR: Yes No DQA: \_\_\_\_\_ Date: \_\_\_\_\_

QA: N/C Closed: \_\_\_\_\_ Date: \_\_\_\_\_

NCR:		WORK ORDER NON-CONFORMANCE (NCR)						
DATE	STEP	Description of NC Section A	Corrective Action Section B			Verification Section C	Approval Chief Eng	Approval QC Inspector
			Initial Chief Eng	Action Description Chief Eng	Sign & Date			

NOTE: Date & initial all entries

Date: Wednesday, 2/20/2008 4:16:58 PM  
User: Kim Johnston

## Process Sheet

Customer: CU-DAR001 Dart Helicopters Services

Drawing Name: BASKET LID ASSEMBLY

Job Number: 37512A

Part Number: D2989041

Job Number:



Seq. #:

Machine Or Operation:

Description :

5.0

M304EX07516F

Expanded Metal Flat Stai



Comment: Qty.: 15.0000 sf(s)/Unit Total : 15.0000 sf(s)

Pick:

Qty Part number Description Batch

15sf M304EX07516F Expanded Metal

M107966

SAD

08/05/14

①

6.0

M304TS0750W065

304 SQ Tube .75x.75x.065W



Comment: Qty.: 31.7709 f(s)/Unit Total : 31.7709 f(s)

3/4" x 3/4" x 0.065" wall 304/316 SS tubing.

Batch: M107967

SAD

08/05/14

①

7.0

LARGE FAB 1

LARGE FABRICATION RESOURCE 1



Comment: LARGE FABRICATION RESOURCE 1

1-Cut (4) D2236-1 From D3166-3 As Per Dwg D2989

SAD

08/05/14

①

2-Drill holes in tubing as D2989-041 per Dwg D2989

3-Deburr and remove all markings on material

4-Weld as per Dwg D2989 and D2989-041 Assembly using Welding Table and corner Jig. Deburr as required

Note: Expanded metal "diamonds" must run lengthwise. Eg 2.0" along length of lid

5-Drill Ø0.257" hole as D2989-041 per Dwg D2989 Identify as D2989-041

08/05/21

08.05.20

PHD

8.0

QC9

VISUAL WELDING INSPECTION



Comment: VISUAL WELDING INSPECTION

PHD

08.05.22

9.0

QC5

INSPECT WORK TO CURRENT STEP



Comment: INSPECT WORK TO CURRENT STEP

10.0

POWDER COATING

POWDER COATING



Comment: POWDER COATING

1-Powder Coat White (Ref. 4.3.5.2) D2989-041 as per QSI 005 4.3 & Dwg D2989

M. H






08/05/14

30m  
23/05/2008  
S.269 08.47  
#1 398.6  
#2 B37812A  
#3  
#4 D2989041

# Dart Aerospace Ltd

W/O: <u>✓</u>		WORK ORDER CHANGES					
DATE	STEP	PROCEDURE CHANGE	By	Date	Qty	Approval Chief Eng / Prod Mgr	Approval QC Inspector

Part No: D2989-041 PAR #: N/A Fault Category: Large Fals NCR: Yes ☒ No ☐ DQA: DP Date: 08/05/22  
 QA: N/C Closed:   Date:  

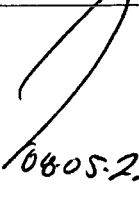NCR: <u>37512A</u>		WORK ORDER NON-CONFORMANCE (NCR)						
DATE	STEP	Description of NC Section A	Corrective Action Section B			Verification Section C	Approval Chief Eng	Approval QC Inspector
			Initial Chief Eng	Action Description Chief Eng	Sign & Date			
08.05.22	9.0	Upon inspection <del>off</del> it was found that the handle clevis's were 0.5" off center, and even with the base. R.C: Lack of attention.		<ul style="list-style-type: none"> <li>It is no handle interference part Acceptable.</li> <li>Employee to be more cautious.</li> </ul>	 08.05.22	 08/05/22	 08/05/22	 08.05.22

NOTE: Date & initial all entries



Date: Wednesday, 2/20/2008 4:16:58 PM  
User: Kim Johnston

## Process Sheet

Customer: CU-DAR001 Dart Helicopters Services

Drawing Name: BASKET LID ASSEMBLY

Job Number: 37512A

Part Number: D2989041

Job Number:



Seq. #:

Machine Or Operation:

Description :

2-Wing walk D2989-041 as per Dwg D2989 and QSI 005 4.4

Spray Paint Black: *m/107603*

Wing Walk: *m/107892*

*Fyl 08/05/23 (P)*

11.0

QC3

INSPECT POWDER COAT/CHEMICAL CONVERSION



Comment: Inspect Powder Coat and Wing Walk

*CP 08/05/23 (P)*

12.0

QC21

FINAL INSPECTION/W/O RELEASE



Comment: FINAL INSPECTION/W/O RELEASE

*08/05/23 (P)*

Job Completion



*MF 08-05-23*

W/O:		WORK ORDER CHANGES					
DATE	STEP	PROCEDURE CHANGE	By	Date	Qty	Approval Chief Eng / Prod Mgr	Approval QC Inspector

Part No: \_\_\_\_\_ PAR #: \_\_\_\_\_ Fault Category: \_\_\_\_\_ NCR: Yes No DQA: \_\_\_\_\_ Date: \_\_\_\_\_

QA: N/C Closed: \_\_\_\_\_ Date: \_\_\_\_\_

NCR:		WORK ORDER NON-CONFORMANCE (NCR)						
DATE	STEP	Description of NC Section A	Corrective Action Section B			Verification Section C	Approval Chief Eng	Approval QC Inspector
			Initial Chief Eng	Action Description Chief Eng	Sign & Date			

NOTE: Date & initial all entries



DESIGN DS	DRAWN BY PH	DART AEROSPACE LTD HAWKESBURY, ONTARIO, CANADA	
CHECKED <i>[Signature]</i>	APPROVED <i>[Signature]</i>	DRAWING NO. D2989	REV. B SHEET 1 OF 3
DATE 05.06.07		TITLE BASKET LID ASSEMBLY	SCALE NTS
A	00.10.27	NEW ISSUE	
B	05.06.07	ADD SHIM UNDER HINGES, UPDATE LID DIMENSIONS	

RELEASED

05.08.19 *[Signature]*

PARTS LIST:

Qty -041	Qty -043	Part Number	Description
X		D2989-041	BASKET LID ASSEMBLY (OUTSIDE)
	X	D2989-043	BASKET LID ASSEMBLY (INSIDE)
	1	D2989-1	STRUT
	1	D2989-2	STRUT
	1	D2989-3	STRUT
	1	D2989-4	STRUT
	2	D2989-5	STRUT
	2	D2989-7	STRUT
1		D2989-9	STRUT
1		D2989-10	STRUT
1		D2989-11	STRUT
1		D2989-12	STRUT
2		D2989-13	STRUT
2		D2989-15	STRUT
2		D2327-3	SPACER BUSHING
1		D2506	LABEL PLATE
2	2	D2989-17	STRUT (96.00" LONG)
2		D2989-19	STRUT (31.19" LONG)
1		D2512-7	STRUT
2		D2581	MOUNTING BRACKET
	2	D3182-1	HINGE
	2	D3442-3	SHIM

UNDER REVIEW  
03.02.21

TUBING TO BE  
CHANGED TO 0.065  
WALL *[Signature]*  
03.02.21


SHOP COPY  
RETURN TO  
ENGINEERING  
UNCONTROLLED COPY  
SUBJECT TO AMENDMENT  
WITHOUT NOTICE  
WORK ORDER  
NO. 37512A

NOTES:

- 1) FRAME MATERIAL: AISI 304/316 SS, 3/4 x 3/4 x 0.060 WALL SQUARE TUBING  
D2989-3/4/5/11/12/13 CAN BE MADE FROM D2236
- 2) MESH MATERIAL: 3/4-16F EXPANDED SS (REF DART SPEC M304EX0.75-16F)
- 3) WELD PER DART QSI 004
- 4) FINISH: POWDER COAT WHITE (REF. 4.3.5.2) PER DART QSI 005 4.3.  
BLACK ANTI-SKID PAINT AS INDICATED PER DART QSI 005 4.4. SPRAY PAINT  
INSIDE SURFACE BLACK PRIOR TO APPLYING ANTI-SKID.
- 5) ALL DIMENSIONS ARE IN INCHES
- 5) TOLERANCES ARE PER DART QSI 018 UNLESS OTHERWISE NOTED

Copyright © 2000 by DART AEROSPACE LTD

THIS DOCUMENT IS PRIVATE AND CONFIDENTIAL AND IS SUPPLIED ON THE EXPRESS CONDITION THAT IT IS NOT TO BE USED FOR ANY PURPOSE OR COPIED OR COMMUNICATED TO ANY OTHER PERSON WITHOUT WRITTEN PERMISSION FROM DART AEROSPACE LTD.


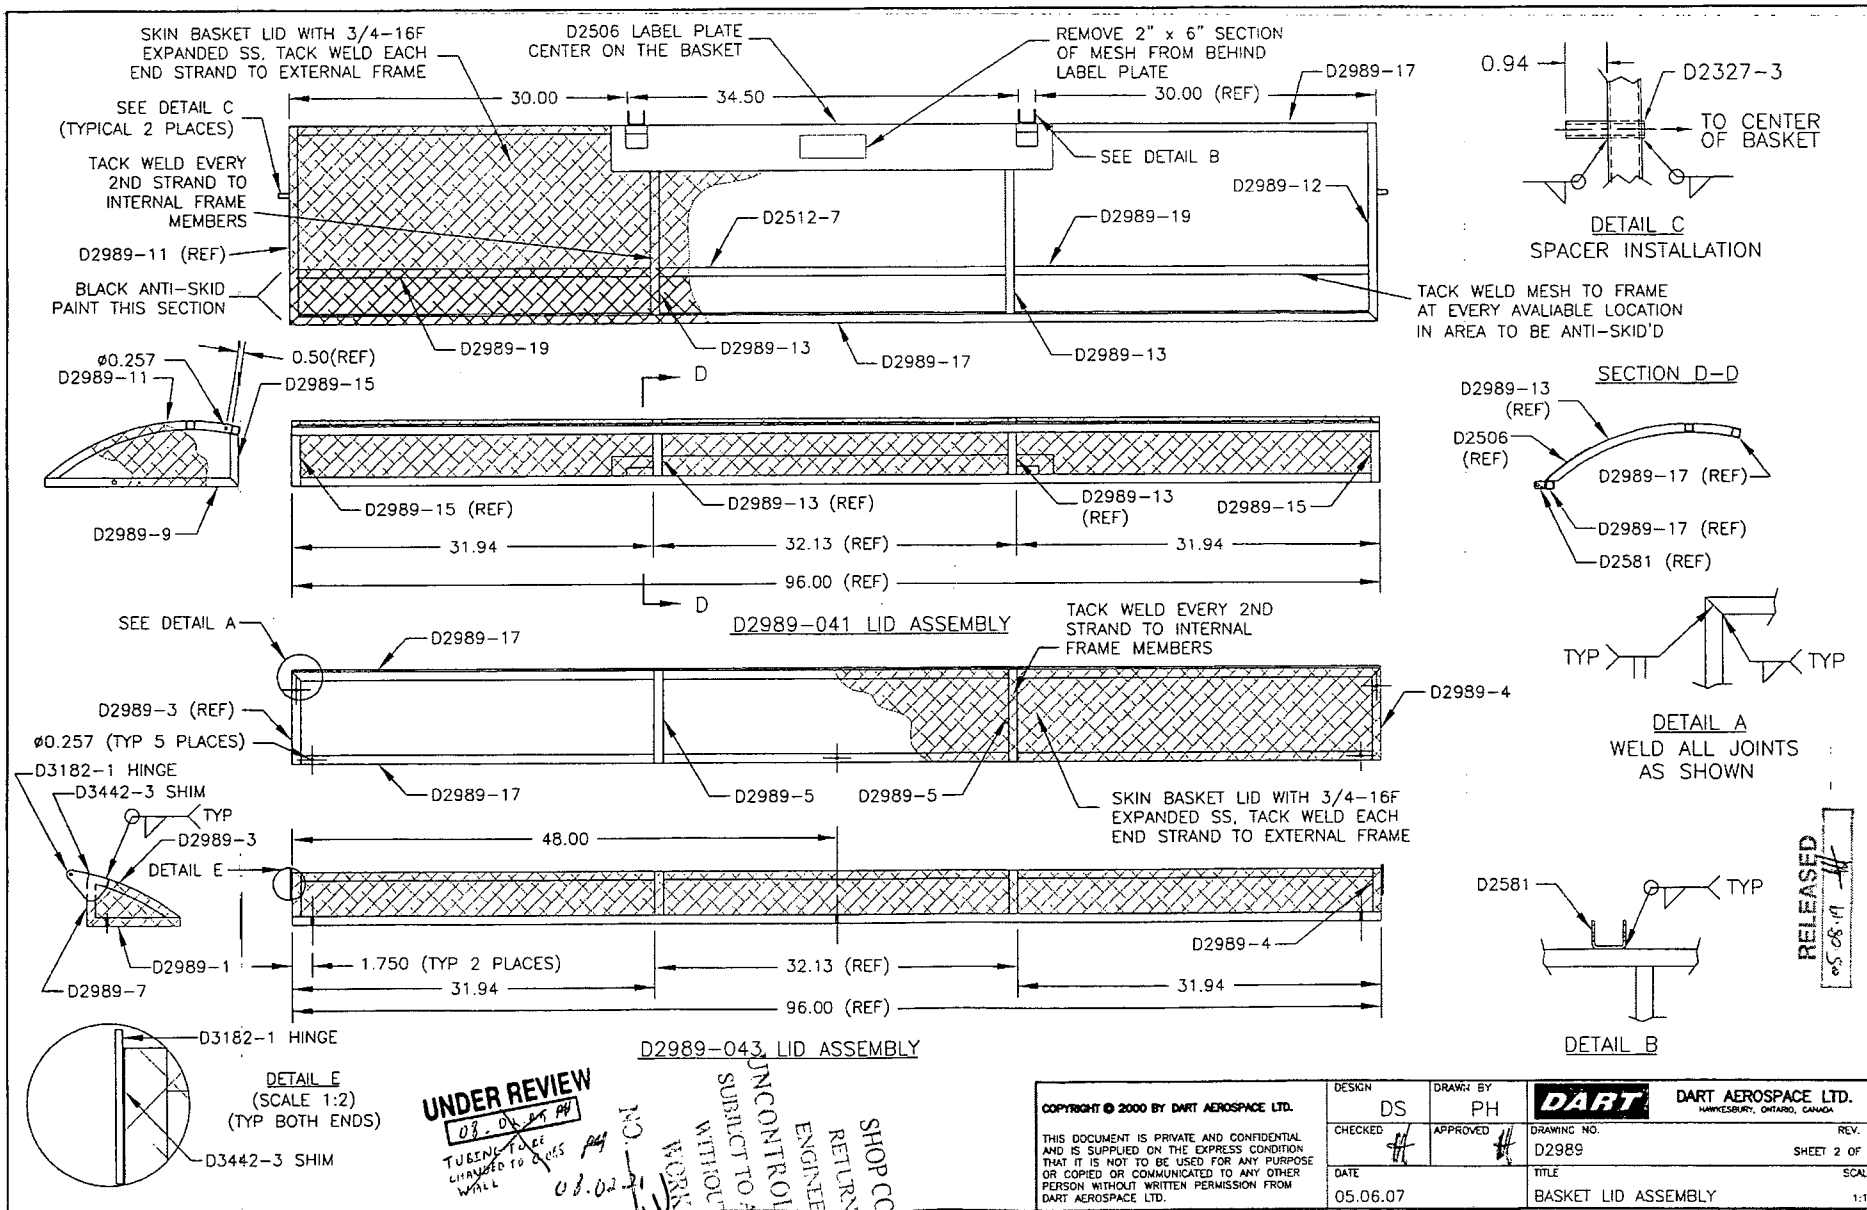


UNDER REVIEW

08.06.07 PH  
TUBING TO BE  
CHANGED TO 0.065 PH



NO. 37512A  
WORK ORDER  
SUBJECT TO AMENDMENT  
WITHOUT NOTICE  
ENGINEERING  
RETURN TO  
SHOP COPY

COPYRIGHT © 2000 BY DART AEROSPACE LTD.		DESIGN	DS	DRAWN BY	PH	<b>DART</b> DART AEROSPACE LTD. WARRICKBURT, ONTARIO, CANADA	REV. B SHEET 2 OF 3 SCALE 1:10
THIS DOCUMENT IS PRIVATE AND CONFIDENTIAL AND IS SUPPLIED ON THE EXPRESS CONDITION THAT IT IS NOT TO BE USED FOR ANY PURPOSE OR COPIED OR COMMUNICATED TO ANY OTHER PERSON WITHOUT WRITTEN PERMISSION FROM DART AEROSPACE LTD.		CHECKED	#	APPROVED	#		
DATE		05.06.07		DRAWING NO.		D2989	
				TITLE		BASKET LID ASSEMBLY	

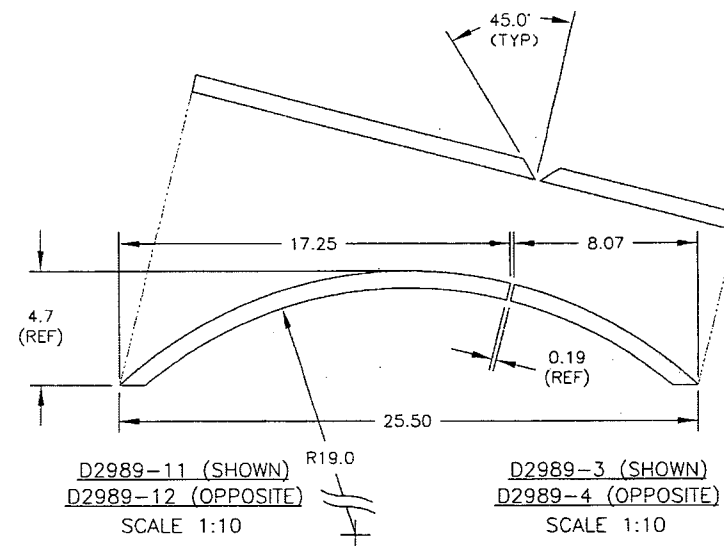
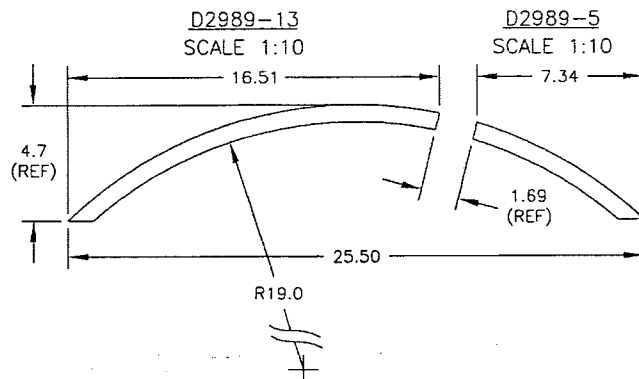


D2989-15  
SCALE 2:5  
(DIMENSIONS LISTED AS REFERENCE ONLY, CUT TO FIT ASSEMBLY)

D2989-7  
SCALE 2:5  
(DIMENSIONS LISTED AS REFERENCE ONLY, CUT TO FIT ASSEMBLY)

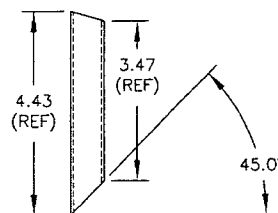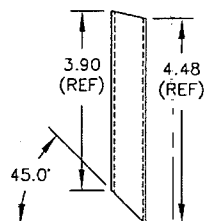

D2989-9 (SHOWN)  
D2989-10 (SIMILAR)  
SCALE 2:5

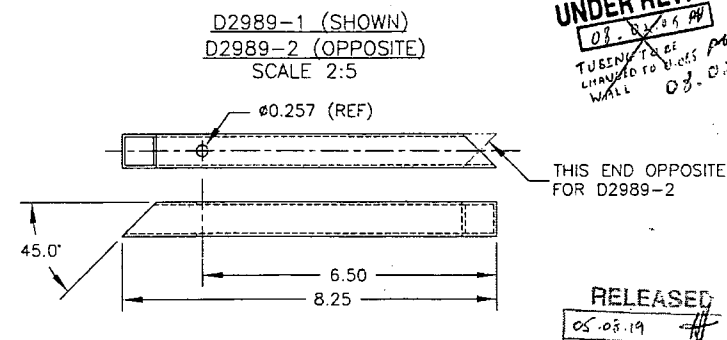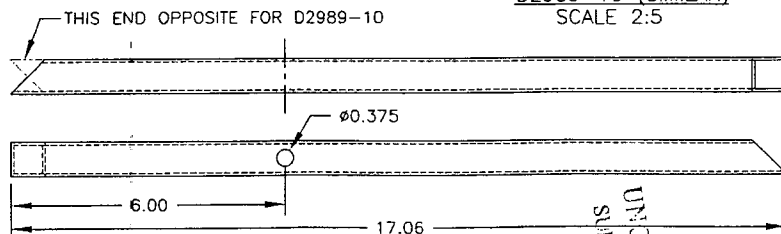

COPYRIGHT © 2000 BY DART AEROSPACE LTD.		DESIGN	DS	DRAWN BY	PH	<b>DART</b>	DART AEROSPACE LTD. MARKHAM, ONTARIO, CANADA
THIS DOCUMENT IS PRIVATE AND CONFIDENTIAL AND IS SUPPLIED ON THE EXPRESS CONDITION THAT IT IS NOT TO BE USED FOR ANY PURPOSE OR COPIED OR COMMUNICATED TO ANY OTHER PERSON WITHOUT WRITTEN PERMISSION FROM DART AEROSPACE LTD.		CHECKED	PH	APPROVED	PH	DRAWING NO.	REV. B
		DATE	05.06.07			D2989	SHEET 3 OF 3
						TITLE	SCALE
						BASKET LID ASSEMBLY	1:10

SHOP COPY  
RETURN TO  
ENGINEERING  
UNCONTROLLED COPY  
SUBJECT TO AMENDMENT  
WITHOUT NOTICE  
WORK ORDER  
NO. 37512A